

RANKIN MISSISSIPPI BOARD OF WATER COMMISSIONERS

X 52  
11-7-62

WATER WELL DRILLERS LOG

CODED

Rankin

Date: Nov. 7, 1962 Driller: W. G. Butler County Smith

(Name)

(1) Owner of Land: <u>Clyde Miley</u> <small>(Name)</small>	Description & Color of Materials Sand, Clay, Red Clay, Shell, etc.	Thick- ness Feet	Depth Feet
<u>Brandon, Miss.</u> <small>(Address)</small>	<u>C12.4 sand</u>	<u>1-10 10-110</u>	<u>10-110</u>
(2) Location: <u>1/4, 1/4, Sec. 11 T3R5</u>	<u>Chalk</u>	<u>40 45</u>	<u>45 50</u>
<u>2</u> miles <u>N.</u> of <u>Puckett</u> <small>(distance) (direction) (Nearest Town)</small>	<u>Sand</u>	<u>70</u>	<u>90</u>
(3) Topography: <input checked="" type="checkbox"/> (Hilly) <input type="checkbox"/> (Flat) <input type="checkbox"/> (Level)	CODED		
(4) Purpose of Well: <u>Domestic</u> <small>(Domestic Irrigation Municipal, Industrial, Other)</small>			


Information upon completion of well:

- (1) Diameter 2 inches.
- (2) Total Depth 90 feet.
- (3) Water Level 60' feet below top of ground:
- (4) Cased to 84', Size 2"
- (5) Screen: Size 2", Length 6'
- (6) Were any formations sealed against pollution?  
\_\_\_\_\_ yes, \_\_\_\_\_ no.

If YES depth of formation \_\_\_\_\_

Why \_\_\_\_\_

Drillers Remarks: \_\_\_\_\_

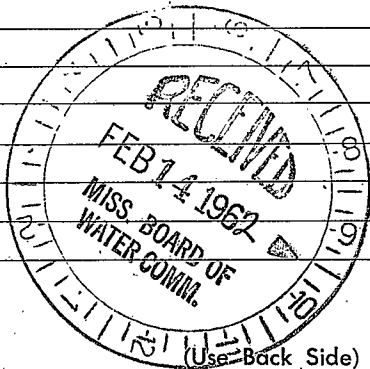

Well No.

