

RANKIN MISSISSIPPI BOARD OF WATER COMMISSIONERS

X 53  
4-19-63

WATER WELL DRILLERS LOG

**CODED**

Date: Apr 17, 19 63, Driller: W. H. Butler County Smith  
New House


(1) Owner of Land: <u>Baron McClain</u> <u>Brandon, Miss, Rt 1</u> <small>(Name)</small> <small>(Address)</small>	Description & Color of Materials Sand, Clay, Red Clay, Shell, etc.	Thick- ness Feet	Depth Feet
(2) Location: <u>2</u> miles <u>West</u> of <u>Puckett</u> <small>(distance)</small> <small>(direction)</small> <small>(Nearest Town)</small> <u>8 st 5A</u> <small>T R</small>			
(3) Topography: <u>Domestic</u> <small>(Hilly)</small> <small>(Flat)</small> <small>(Level)</small>			
(4) Purpose of Well: <u>Domestic</u> <small>(Domestic Irrigation)</small> <small>(Municipal, Industrial, Other)</small>			

**CODED**

Information upon completion of well:

- (1) Diameter 2 inches.
- (2) Total Depth 50 feet.
- (3) Water Level 20 feet below top of ground.
- (4) Cased to 45, Size 2"
- (5) Screen: Size 2", Length 5'
- (6) Were any formations sealed against pollution?  
\_\_\_\_\_ yes, \_\_\_\_\_ no.

If YES depth of formation \_\_\_\_\_  
Why \_\_\_\_\_  
Drillers Remarks: \_\_\_\_\_

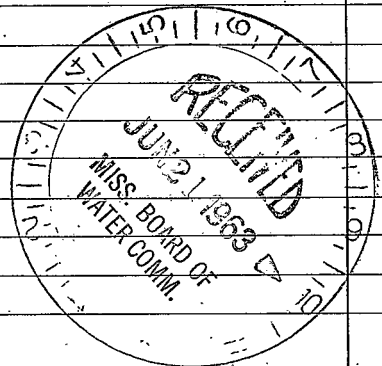

(Use Back Side).

Well No.

1911