

RANKIN MISSISSIPPI BOARD OF WATER COMMISSIONERS

X 54
4-30-63

WATER WELL DRILLERS LOG

CODED

Date: April 30, 1963, Driller: W. G. Butler County Smith
Old House (Name)

(1) Owner of Land:	Description & Color of Materials Sand, Clay, Red Clay, Shell, etc.	Thick- ness Feet	Depth Feet
(Name) <u>Garon McClain</u> <u>Brandon, Rt. 1. Miss</u> (Address)	<u>Chalk</u> <u>sand</u>	<u>1</u>	<u>10</u>
(2) Location: <u>8</u> <u>1/4</u> , <u>1/4</u> , Sec. <u>8</u> <u>1/4</u> <u>SE</u> <u>2</u> miles <u>West</u> of <u>Puckett</u> (distance) (direction) (Nearest Town)			
(3) Topography: <input checked="" type="checkbox"/> (Hilly) <input type="checkbox"/> (Flat) <input type="checkbox"/> (Level)			
(4) Purpose of Well: <u>Domestic</u> (Domestic Irrigation, Municipal, Industrial, Other)			

Information upon completion of well:


- (1) Diameter 2 inches.
- (2) Total Depth 40 feet.
- (3) Water Level 20 feet below top of ground.
- (4) Cased to 35, Size 2"
2", Length 5'
- (5) Screen: Size _____, Length _____
- (6) Were any formations sealed against pollution?
_____ yes, _____ no.

If YES depth of formation _____

Why _____

Drillers Remarks: _____

CODED

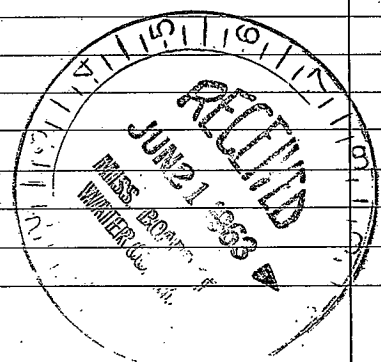

(Use Back Side)

Well No.

