

RANKIN MISSISSIPPI BOARD OF WATER COMMISSIONERS

X 55
6-6-63

WATER WELL DRILLERS LOG

CODED

Date: June 6, 1963, Driller: W. G. Butler County: Smith

(Name)

	Description & Color of Materials. Sand, Clay, Red Clay, Shell, etc.	Thick- ness Feet	Depth Feet
(1) Owner of Land: <u>A. R. Womack</u> <u>Mendenhall</u> , Miss. (Name)	<u>Chalk</u>	<u>12</u>	<u>10</u>
(Address) <u>33 3/4 SE</u>	<u>Blue chalk</u>	<u>20</u>	<u>30</u>
(2) Location: <u>3</u> <u>South</u> <u>Packett</u> miles (distance), (direction) of (Nearest Town)	<u>Blue chalk + rock</u>	<u>30</u>	<u>57</u>
(3) Topography: <u>Domestic</u> (Hilly) (Flat) (Level)	<u>sand</u>	<u>57</u>	<u>60</u>
(4) Purpose of Well: <u>Domestic</u> (Domestic Irrigation Municipal, Industrial, Other)	<u>Rock</u>	<u>60</u>	<u>70</u>
	<u>chalk</u>	<u>70</u>	<u>80</u>
	<u>Rock</u>	<u>80</u>	<u>95</u>
	<u>fine sand</u>	<u>95</u>	<u>105</u>
	<u>Blue chalk</u>	<u>105</u>	<u>140</u>
	<u>fine sand + chalk</u>	<u>140</u>	<u>160</u>
	<u>sand + chalk</u>	<u>160</u>	<u>170</u>
	<u>sand</u>	<u>170</u>	<u>180</u>

Information upon completion of well:


- (1) Diameter 2 inches. 180
- (2) Total Depth 40 feet.
- (3) Water Level 168 feet below top of ground. 2"
- (4) Cased to 2", Size 10'
- (5) Screen: Size 2", Length 10'
- (6) Were any formations sealed against pollution?
_____ yes, _____ no.

If YES depth of formation _____

Why _____

Drillers Remarks: _____

CODED

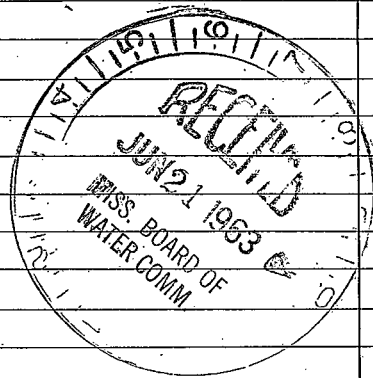

(Use Back Side)

Well No.

