

X 56
6-17-63

WATER WELL DRILLERS LOG **CODED**

Date: June 17, 1963, Driller: W. G. Butler County Smith

(Name)

(1) Owner of Land: Mrs. H. Dawsey
Brandon - Rt. - Miss
 (Address)

(2) Location: 32 3/4 5
4 miles S. West Pockett, of _____
 (distance) (direction) (Nearest Town)

(3) Topography: _____
 (Hilly) (Flat) (Level)

(4) Purpose of Well: Domestic
 (Domestic Irrigation
 Municipal, Industrial, Other)

Description & Color of Materials Sand, Clay, Red Clay, Shell, etc.	Thick- ness Feet	Depth Feet
<u>Chalk</u>	<u>1-</u>	<u>10</u>
<u>Fine sand</u>	<u>10-</u>	<u>15</u>
<u>Blue chalk</u>	<u>15-</u>	<u>25</u>
<u>Fine sand</u>	<u>25-</u>	<u>34</u>
<u>Rock</u>	<u>34-</u>	<u>38</u>
<u>sand</u>	<u>36-</u>	<u>60</u>
<u>sand & chalk</u>	<u>60-</u>	<u>65</u>
<u>sand</u>	<u>65-</u>	<u>81</u>

Information upon completion of well:

(1) Diameter 2 inches

(2) Total Depth 81 feet Top of the Ground

(3) Water Level 74 feet below top of ground 2"

(4) Cased to _____, Size _____

(5) Screen: Size 2, Length 5'


(6) Were any formations sealed against pollution?
 _____ yes, _____ no.

CODED

If YES depth of formation _____

Why _____

Drillers Remarks: _____

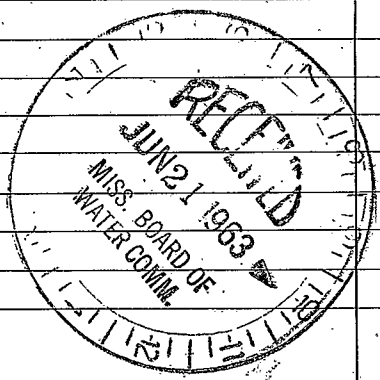

(Use Back Side)

Well No.

