

RANKIN MISSISSIPPI BOARD OF WATER COMMISSIONERS

X 57  
8-20-63

WATER WELL DRILLERS LOG

**CODED**

Date: aug. 20, 19 63, Driller: W. H. Butler County Smith  
(Name)

(1) Owner of Land: H. C. Williams  
(Name)  
Brandon, Miss.  
(Address) Rt -

(2) Location: 1/4, 1/4, Sec. 31 E 1/4 SE  
6 miles S.W., of Puckett  
(distance) (direction) (Nearest Town)

(3) Topography: ✓  
(Hilly) (Flat) (Level)

(4) Purpose of Well: Domestic  
(Domestic Irrigation  
Municipal, Industrial, Other)

Description & Color of Materials Sand, Clay, Red Clay, Shell, etc.	Thick- ness- Feet	Depth Feet
Clay + sand	1-20	
Blue chalk	20-30	
Rock + chalk	30-35	
Rock + sand	35-40	
sand + chalk	40-60	
Rock + sand	60-65	
Sand	65-104	

Information upon completion of well:

(1) Diameter 2 inches.

(2) Total Depth 104 feet.

(3) Water Level \_\_\_\_\_ feet below top of ground.

(4) Cased to 99, Size 2"

(5) Screen: Size 2", Length 5'


(6) Were any formations sealed against pollution?  
\_\_\_\_\_ yes, \_\_\_\_\_ no.

If YES depth of formation \_\_\_\_\_

Why \_\_\_\_\_

Drillers Remarks: \_\_\_\_\_

**CODED**

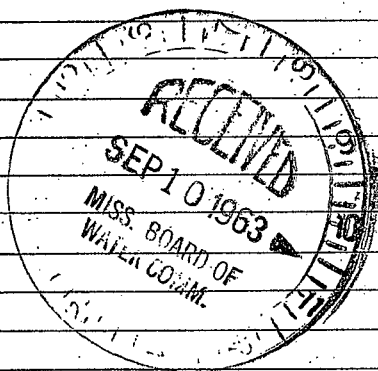

(Use Back Side)

Well No.

Handwritten header text, possibly a date or page number.

Main body of handwritten text, appearing to be a list or series of entries.

Second section of handwritten text, continuing the list or entries.

Final section of handwritten text at the bottom of the page.