

RANKIN MISSISSIPPI BOARD OF WATER COMMISSIONERS

X 59
5-20-64

WATER WELL DRILLERS LOG

CODED

Date: May 20, 1964, Driller: W. J. Butler County Smith
(Name)

(1) Owner of Land: John Lee Overlin
(Name)
Brandon Miss.
(Address)

(2) Location: 1/4, 1/4, Sec. 2 DRIVE
2 miles East, of Johns
(distance) (direction) (Nearest Town)

(3) Topography: (Hilly) (Flat) (Level)

(4) Purpose of Well: Domestic
(Domestic Irrigation
Municipal, Industrial, Other)

Description & Color of Materials Sand, Clay, Red Clay, Shell, etc.	Thick- ness: Feet	Depth Feet
Chalk	1-	15
Red Sand	15	20
Chalk + Sand	20	40
Chalk	40	55
Sand	55	60
sand + chalk	60	80
Chalk	80	100
Chalk + Sand	100	105
Sand	105	110
Chalk	110	120
Sand	120	125

Information upon completion of well:

(1) Diameter 2" inches.

(2) Total Depth 125 feet.

(3) Water Level 50 feet below top of ground.

(4) Cased to 118, Size 2"

(5) Screen: Size 2, Length 5'


(6) Were any formations sealed against pollution?
_____ yes, _____ no.

If YES depth of formation _____

Why _____

Drillers Remarks: _____

CODED

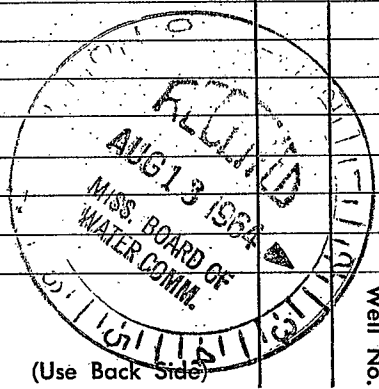

(Use Back Side)

1. The first part of the document discusses the importance of maintaining accurate records of all transactions. It emphasizes that this is crucial for the company's financial health and for providing reliable information to stakeholders.

2. The second part of the document outlines the specific procedures for recording transactions. It details the steps from initial entry to final review, ensuring that all necessary information is captured and verified.

3. The third part of the document addresses the role of the accounting department in this process. It highlights the need for clear communication and collaboration between different departments to ensure the accuracy and completeness of the records.

4. The fourth part of the document discusses the importance of regular audits and reviews. It explains how these activities help to identify any discrepancies or errors and ensure that the records are up-to-date and accurate.

5. The fifth part of the document provides a summary of the key points discussed and offers some final thoughts on the importance of maintaining accurate records.

Conclusion

In conclusion, maintaining accurate records of all transactions is a fundamental responsibility of the accounting department. It is essential for the company's financial health and for providing reliable information to stakeholders. The procedures outlined in this document are designed to ensure that all transactions are recorded accurately and completely. The accounting department plays a key role in this process, and clear communication and collaboration between departments are essential for success. Regular audits and reviews are also important to ensure that the records are up-to-date and accurate. By following these procedures, the company can ensure that its financial records are reliable and accurate.