

RANKIN MISSISSIPPI BOARD OF WATER COMMISSIONERS

X 62
3-7-66

WATER WELL DRILLERS LOG

CODED

Date: May 7, 1966, Driller: W. G. Butler County Rankin
(Name)

(1) Owner of Land Reginald Allen
(Name)
Brandon Rd 1-
(Address)

(2) Location: 1/4, 1/4, Sec. 16 T3R5E
1/4 miles W of Puckett
(distance) (direction) (Nearest Town)

(3) Topography: (Hilly) (Flat) (Level)

(4) Purpose of Well: Domestic
(Domestic Irrigation
Municipal, Industrial, Other)

Description & Color of Materials Sand, Clay, Red Clay, Shell, etc.	Thick- ness Feet	Depth Feet
<u>027</u>	<u>1-</u>	<u>10</u>
<u>Chalk + sand</u>	<u>10-</u>	<u>20</u>
<u>sand</u>	<u>20-</u>	<u>30</u>
<u>sand + Chalk</u>	<u>30-</u>	<u>40</u>
<u>sand</u>	<u>40-</u>	<u>56</u>

CODED

Information upon completion of well:

(1) Diameter 2" inches.

(2) Total Depth 56 feet.


(3) Water Level _____ feet below top of ground.

(4) Cased to 5', Size 2"

(5) Screen: Size 2', Length 5'

(6) Were any formations sealed against pollution?
_____ yes, _____ no.

If YES depth of formation _____
Why _____
Drillers Remarks: _____

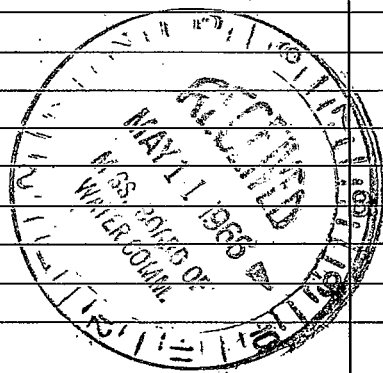

(Use Back Side)

Well No.

