

Rankin
X 65
9-66

MISSISSIPPI BOARD OF WATER COMMISSIONERS

CODED

WATER WELL DRILLERS LOG

Date: Sept 15, 1966 Driller: W. H. Butler County RANKIN
(When well drilled) (Name) (Where well is located)

(1) Owner of Land: Joe Winstead
(Name)
Brandon Rt. 1, Miss.
(Address)

Description & Color of Materials Sand, Clay, Red Clay, Shell, etc.	Thick- ness Feet	Depth Feet
<u>Red Clay</u>	<u>10</u>	<u>10</u>
<u>Sand</u>	<u>85</u>	<u>95</u>

(2) Location: NE 1/4, NE 1/4, Sec. 11 T3R5
_____ miles _____ of _____
(distance) (direction) (Nearest Town)


(3) Topography: _____
(Hilly) (Flat) (Level)

(4) Purpose of Well: Domestic
(Domestic Irrigation
Municipal, Industrial, Other)

Information upon completion of well:

- (1) Diameter 2" inches.
- (2) Total Depth 95' feet.
- (3) Water Level 35' feet below top of ground.
- (4) Cased to 90, Size 2"
- (5) Screen: Size 2", Length 5'
- (6) Were any formations sealed against pollution?
_____ yes, no.

CODED

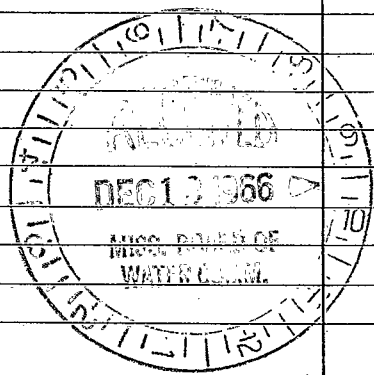

YES depth of formation _____
/hy _____
Drillers Remarks: _____
Yield in gpm: 15 gal.
Size pump: Air Com P.
Type power: Electric

