

Rankin  
 X 68  
 3-67

MISSISSIPPI  
 BOARD OF WATER COMMISSIONERS  
 416 North State Street  
 Jackson, Mississippi 39201

**CODED**

WATER WELL DRILLERS LOG

Mar. 10 19 67 W. G. Butler Rankin  
 date well completed firm name county well located

LANDOWNER:

description of formations encountered

from to

Herman Ainsworth  
 Brandon, Miss.  
 (mailing address)

CLAY  
 CHALK + SAND 1 10  
 10-30  
 ROCK 20-30  
 SAND 30-60  
 CHALK 60-90  
 SAND 70-90

WELL LOCATION:

sec. 32 T 3 N R. 5 E  
 S W  
 3 miles South of Pickett  
 (distance) (direction) (nearest town)

WELL PURPOSE: Home  
 (home, irrigation, municipal, industrial)

WELL COMPLETION DATA:

- (1) diameter (inches) 2"
- (2) total depth (feet) 91'
- (3) static water level (feet) 20 <sup>below</sup> <sub>above</sub> top of ground.
- (4) casing Galv. 84'  
 (material) (depth)  
 2" If telescope see back.  
 (size)
- (5) screen 5 84'  
 (length) (depth to top)  
 2" Stainless Steel  
 (size) (material)
- (6) pump 3/4 10  
 (HP) (yield gpm)  
 Electric  
 (type power)
- (7) electric log No  
 (yes or no)

**CODED**


(organization running log)

(8) how well bottom plugged 2" Back  
 Wash 1/2 1/2

DRILLERS REMARKS:

If well telescopes please sketch and show depths.

GROUND LEVEL

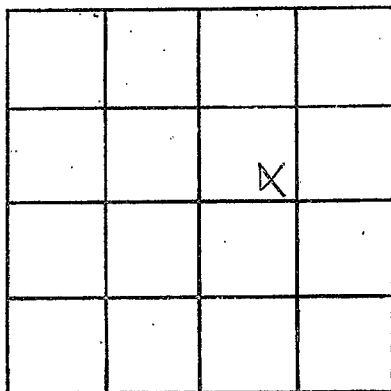

SECTION 32

Please indicate well location X.

ADDITIONAL INFORMATION

If more than one screen, show locations of each on sketch.