

Rankin
X71
7-2-68

MISSISSIPPI
BOARD OF WATER COMMISSIONERS
416 North State Street
Jackson, Mississippi 39201

CODED

WATER WELL DRILLERS LOG

July 2 1968 W.H. Butler Rankin
date well completed firm name county well located

LANDOWNER:
Victor Bankston
Brandon Rt. 2 -
(mailing address)

description of formations encountered	from	to
CLAY	0	10
CHALK & SAND	10	20
SAND	20	37
CHALK	37	40
FINE SAND & CHALK	40	60


WELL LOCATION:
sec. 8 T. 3 N. R. 5 E
1 1/2 miles N of Puckett
(distance) (direction) (nearest town)

WELL PURPOSE: HOME
(home, irrigation, municipal, industrial)

WELL COMPLETION DATA:

(1) diameter (inches) 2"
(2) total depth (feet) 60
(3) static water level (feet) 30 below top of ground.
(4) casing P.W.C. 55 (material) (depth)
2 (size) if telescope see back.
(5) screen 5' 55 (length) (depth to top)
2" S.S. (size) (material)
(6) pump 3/4 HP (HP) 10 (yield gpm)
Electric (type power)
(7) electric log No (yes or no)
(organization running log)
(8) how well bottom plugged 2" Bull


CODED

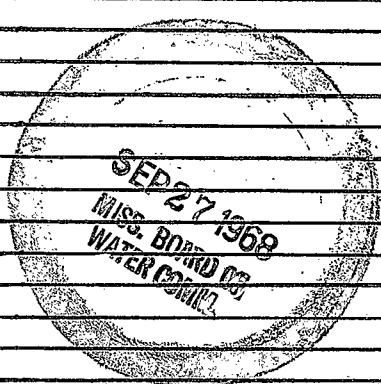

DRILLERS REMARKS:

If well telescopes please sketch and show depths.

GROUND LEVEL

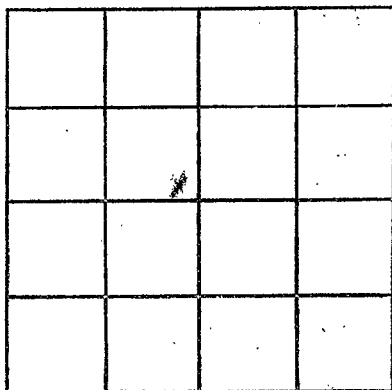

SECTION 7

Please indicate well location X.

ADDITIONAL INFORMATION

If more than one screen,
show locations of each on sketch.