

Rankin
X72
7-29-68

MISSISSIPPI
BOARD OF WATER COMMISSIONERS
416 North State Street
Jackson, Mississippi 39201

CODED

WATER WELL DRILLERS LOG

July 29 1968 W. G. Butler Rankin
date well completed firm name county well located

LANDOWNER:
County Line Church
Mendenhall
(mailing address)

description of formations encountered	from	to
Red Clay + SAND	0	10
SAND + CHALK	10	20
CHALK	20	25
SAND	25	40
SAND + CHALK	40	50
SAND	50	70
SAND + CHALK	70	110
SAND	110	130

WELL LOCATION:
sec 32 T. 3(N) R. 5(E)
S
3 miles SW of Puckett
(distance) (direction) (nearest town)

WELL PURPOSE:
(home, irrigation, municipal, industrial)

WELL COMPLETION DATA:

(1) diameter (inches) 2"

(2) total depth (feet) 130'

(3) static water level (feet) 70' below top of ground.

(4) casing 9211, 119, 2" (material), (depth), (size) If telescope see back.

(5) screen 10', 119 (length), (depth to top), 2" (size), S.S. (material)


(6) pump Air Comp 2 (HP), (yield gpm), Electric (type power)

(7) electric log No (yes or no)

(organization running log)

(8) how well bottom plugged 2" R.W.V.


CODED

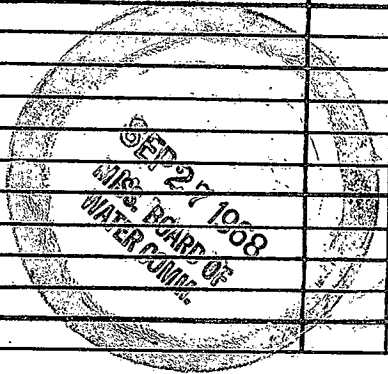

DRILLERS REMARKS:

well telescopes please
sketch and show depths.

GROUND LEVEL

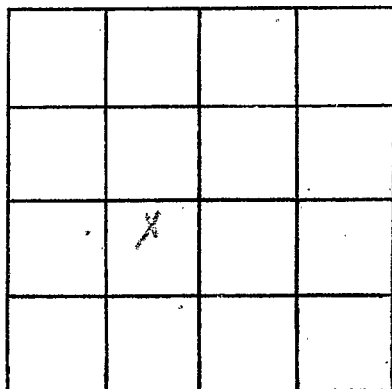

SECTION 22

Please indicate well location X.

ADDITIONAL INFORMATION

If more than one screen,
show locations of each on sketch.