

MISSISSIPPI
BOARD OF WATER COMMISSIONERS
416 North State Street
Jackson, Mississippi 39201

CODED

WATER WELL DRILLERS LOG

Rankin
X 73
9-17-69

Sept 17 1969 Thompson Well Dr Rankin
date well completed firm name county well located


LANDOWNER:	description of formations encountered	from	to
<u>E. J. Gibson</u>			
<u>Puckett Miss.</u> (mailing address)	<u>sandy</u>	<u>0</u>	<u>20</u>
WELL LOCATION:	<u>Blue Clay</u>	<u>20</u>	<u>80</u>
sec. <u>25</u> T. <u>3</u> N. R. <u>5</u> E	<u>sand</u>	<u>80</u>	<u>100</u>
<u>2</u> miles <u>5/12</u> of <u>Puckett</u> (distance) (direction) (nearest town)	<u>Blue Clay</u>	<u>100</u>	<u>255</u>
WELL PURPOSE:	<u>Lime sand</u>	<u>255</u>	<u>290</u>
(home, irrigation, municipal, industrial)	<u>Brown Clay</u>	<u>290</u>	<u>323</u>
WELL COMPLETION DATA:			
(1) diameter (inches) <u>2"</u>			
(2) total depth (feet) <u>323</u>			
(3) static water level (feet) <u>38</u> below above top of ground.			
(4) casing <u>Plastic 82'</u> (material) (depth)			
<u>2"</u> if telescope see back. (size)			
(5) screen <u>10'</u> <u>82'</u> (length) (depth to top)			
<u>2"</u> <u>Plastic</u> (size) (material)			
(6) pump <u>1</u> <u>6</u> (HP) (yield gpm)			
<u>Gas</u> (type power)			
(7) electric log <u>yes</u> (yes or no)			
<u>M.S.S.</u> (organization running log)			
(8) how well bottom plugged <u>B/w rock</u>			
DRILLERS REMARKS:			

CODED

OCT 31 1969
MISS. STATE BOARD OF WATER COMMISSIONERS

If well telescopes please sketch and show depths.

GROUND LEVEL

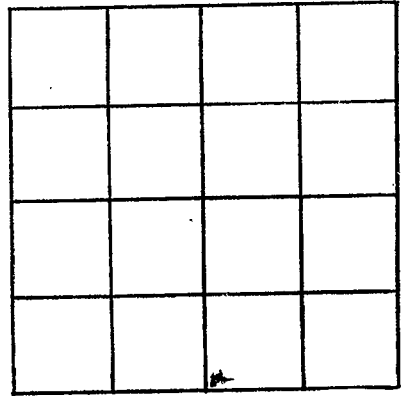

SECTION 25

Please indicate well location X.

ADDITIONAL INFORMATION

If more than one screen,
show locations of each on sketch.