

**Rankin**  
**X-75**  
**5-12-70**

MISSISSIPPI  
 BOARD OF WATER COMMISSIONERS  
 416 North State Street  
 Jackson, Mississippi 39201

**CODED**

**3 AD WATER WELL DRILLERS LOG**

date well completed: May 12 1970 firm name: W. G. Butler county well located: Rankin

**LANDOWNER:**

S. J. Hutson  
Brandon Rd  
 (mailing address)

**description of formations encountered**

from to

Clay + Rock	0	20
Clay	20	50
Clay + Sand	50	70
Sand	70	90
Clay + Sand	80	90
Sand	90	100

**WELL LOCATION:**

sec. 33 T. 3 N. R. 5 E. 042  
2 miles SW of Puckett  
 (distance) (direction) (nearest town)

**WELL PURPOSE:** home  
 (home, irrigation, municipal, industrial)

**WELL COMPLETION DATA:**

- (1) diameter (inches) 2"
- (2) total depth (feet) 100'
- (3) static water level (feet) \_\_\_\_\_ below above top of ground.
- (4) casing galv., 91',  
 (material) (depth)  
2" if telescope see back.  
 (size)
- (5) screen 5', 91'  
 (length) (depth to top)  
2", SS  
 (size) (material)
- (6) pump Root, 4,  
 (HP) (yield/gpm)  
Electric  
 (type power)
- (7) electric log No  
 (yes or no)

**CODED**

(organization running log)

(8) how well bottom plugged 2" Bore


**JUN 5 1970**

**DRILLERS REMARKS:**

MISS. BD. OF  
 WATER COMMISSIONERS

If well telescopes please sketch and show depths.

GROUND LEVEL

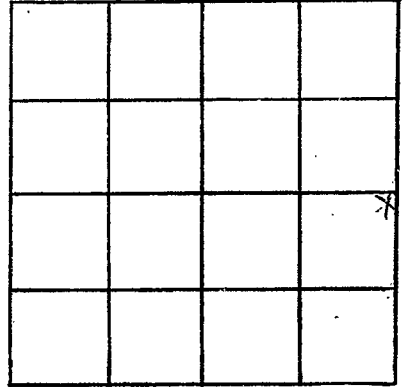

SECTION 33

Please indicate well location X.

ADDITIONAL INFORMATION

If more than one screen, show locations of each on sketch.