

RANKIN

ltr 3-13-70

Grid-X-76  
3-3-70

MISSISSIPPI BOARD OF WATER COMMISSIONERS  
416 North State Street  
Jackson, Mississippi 39201

CODED

WATER WELL DRILLERS LOG RANKIN

Mar 3-1970 W. G. Butler S. Jackson  
date well completed firm name county well located

LANDOWNER:

Harold Steiner  
Mendenhall, Miss  
(mailing address) RT -

description of formations encountered from to

WELL LOCATION:

sec 30 T 30 R 50 S  
2 1/2 miles SW of Puckett  
(distance) (direction) (nearest town)

|                       |     |     |
|-----------------------|-----|-----|
| Rock + c. 12 1/2      | 0   | 10  |
| Rock 1                | 10  | 20  |
| Rock + c. 12 1/2      | 20  | 50  |
| Sand + c. 12 1/2      | 50  | 60  |
| Rock c. 12 1/2 + sand | 60  | 70  |
| Sand + c. 12 1/2      | 70  | 85  |
| Rock + c. 12 1/2      | 85  | 90  |
| Sand + c. 12 1/2      | 90  | 100 |
| Rock sand clay        | 100 | 110 |
| Rock 1                | 110 | 120 |
| Rock + c. 12 1/2      | 120 | 130 |
| Rock 1                | 130 | 140 |
| Rock + c. 12 1/2      | 140 | 150 |
| Sand + c. 12 1/2      | 150 | 180 |
| c. 12 1/2             | 170 | 180 |
| Sand                  | 180 | 250 |

WELL PURPOSE:

Home (home, irrigation, municipal, industrial)

WELL COMPLETION DATA:

- (1) diameter (inches) 2"
- (2) total depth (feet) 253
- (3) static water level (feet) 100' below top of ground
- (4) casing 2 1/2" material, 2 1/4" (depth)
- 2" (size) if telescope see back.
- (5) screen 10' length, 2 1/4" (depth to top)
- 2" (size), S.S. (material)
- (6) pump Aircom 16 (HP), (yield gpm)
- Electric (type power)
- (7) electric log NO (yes or no)
- (organization running log)
- (8) how well bottom plugged 2" B.V.

Check location  
3" is not in Simpson Co.

CODED


MAR 9 - 1970

MISS. BD. OF WATER COMMISSIONERS

DRILLERS REMARKS:

If well telescopes please sketch and show depths.

GROUND LEVEL

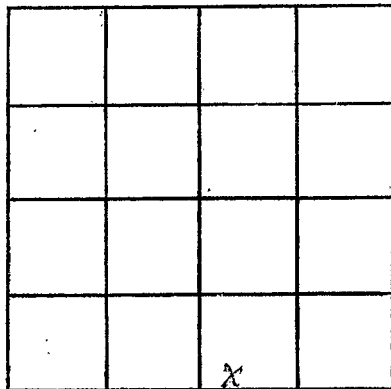

SECTION 31

Please indicate well location X.

ADDITIONAL INFORMATION

If more than one screen,  
show locations of each on sketch.