

MISSISSIPPI
BOARD OF WATER COMMISSIONERS
416 North State Street
Jackson, Mississippi 39201

CODED

WATER WELL DRILLERS LOG

Rankin
X 77
6-27-70

June 27 1970 R. E. Thompson Rankin
date well completed firm name county well located

LANDOWNER:
Billy Ray

description of formations encountered	from	to
	<u>top soil</u>	<u>0</u>

(mailing address)

<u>Blue & Gray clay</u>	<u>20</u>	<u>29</u>
-----------------------------	-----------	-----------

WELL LOCATION:
sec 4 T 3 N R 5 E
2 1/2 miles SE of Johns
(distance) (direction) (nearest town)

<u>sand</u>	<u>29</u>	<u>49</u>
-------------	-----------	-----------

WELL PURPOSE: house
(home, irrigation, municipal, industrial)

WELL COMPLETION DATA:

- (1) diameter (inches) 2"
 - (2) total depth (feet) 49'
 - (3) static water level (feet) 25' below above top of ground.
 - (4) casing Plastic 37'
(material) (depth)
2"
(size) if telescope see back.
 - (5) screen 12' 37'
(length) (depth to top)
1/4" Plastic
(size) (material)
 - (6) pump 3/4 6
(HP) (yield gpm)
Jet
(type power)
 - (7) electric log no
(yes or no)
- (organization running log)

CODED

(8) how well bottom plugged B/W valve


III 1 1970

DRILLERS REMARKS:

MISS. Bd. of
Water Comm.

If well telescopes please sketch and show depths.

GROUND LEVEL

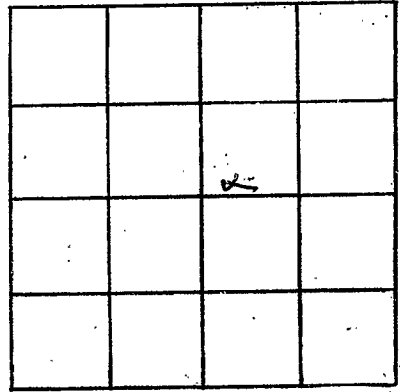

SECTION 4

Please indicate well location X.

ADDITIONAL INFORMATION

If more than one screen, show locations of each on sketch.