

MISSISSIPPI
BOARD OF WATER COMMISSIONERS
416 North State Street
Jackson, Mississippi 39201

CODED

WATER WELL DRILLERS LOG

RANKIN
X 78
9-15-70

Sept. 15 1970 N. E. Thomas Rankin
date well completed firm name county well located

LANDOWNER:
Ray Cox
Johns miss.
(mailing address)

description of formations encountered	from	to
<u>top soil</u>	<u>0</u>	<u>10</u>
<u>sandy</u>	<u>10</u>	<u>80</u>
<u>sand</u>	<u>80</u>	<u>85</u>

WELL LOCATION:
sec. 6 T 3 N R 5 E
8 #
ad miles South of
(distance) (direction) (nearest town)

WELL PURPOSE: home
(home, irrigation, municipal, industrial)

- WELL COMPLETION DATA:
- (1) diameter (inches) 2"
 - (2) total depth (feet) 85'
 - (3) static water level (feet) 17 below above top of ground.
 - (4) casing Plastic 80'
(material) (depth)
2"
(size) if telescope see back.
 - (5) screen 5' 80'
(length) (depth to top)
2" Plastic
(size) (material)
 - (6) pump 1/2 6
(HP) (yield gpm)
Gas
(type power)
 - (7) electric log _____
(yes or no)

(organization running log)
 - (8) how well bottom plugged plugged

CODED


OCT 14 1970

DRILLERS REMARKS:

MISS. BD. OF
WATER COMM.

If well telescopes please sketch and show depths.

GROUND LEVEL

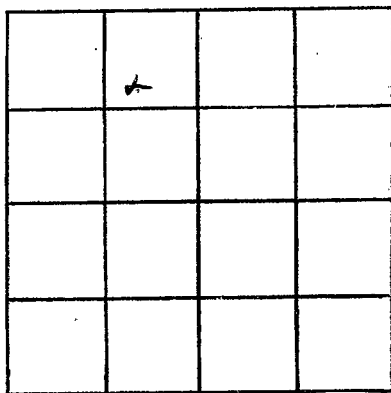

SECTION 6

Please indicate well location X.

ADDITIONAL INFORMATION

If more than one screen,
show locations of each on sketch.