

MISSISSIPPI
BOARD OF WATER COMMISSIONERS
416 North State Street
Jackson, Mississippi 39201

CODED

WATER WELL DRILLERS LOG

RANKIN
X 79.
4-13-71

4-13 1971 Forest Drilling Ser. Rankin
date well completed firm name county well located

LANDOWNER: T.V. White
Route 2, Mendenhall
Miss.
(mailing address)

WELL LOCATION:
sec. 28 T. 3 N R. 5 E
1 miles S.W. of Puckett
(distance) (direction) (nearest town)

WELL PURPOSE: poultry house
(home, irrigation, municipal, industrial)

- WELL COMPLETION DATA:
- (1) diameter (inches) 2"
 - (2) total depth (feet) 208
 - (3) static water level (feet) 45 below above top of ground.
 - (4) casing Alu. 198'
(material) (depth)
2" if telescope see back.
(size)
 - (5) screen 10ft. 198
(length) (depth to top)
2" #20 Stainless Steel
(size) (material)
 - (6) pump unknown - 25 GPM
(HP) (yield gpm)
Elec - (A) 110
(type power)
 - (7) electric log no
(yes or no)
- (organization running log)
- (8) how well bottom plugged 2"
Backwash valve

description of formations encountered	from	to
Clay	0	20
Clay + streaks of sand	20	40
red sand + clay	40	60
Red sand	60	86
Clay	76	81
Blue Clay	81	122
Clay + streaks fine sand	122	150
fine sand	150	158
Clay	158	163
fine sand	163	173
Clay + streaks fine sand	173	180
fine sand	180	208

CODED


APR 16 1971

DRILLERS REMARKS:

MISS. BD. OF
WATER COMM.

If well telescopes please sketch and show depths.

GROUND LEVEL

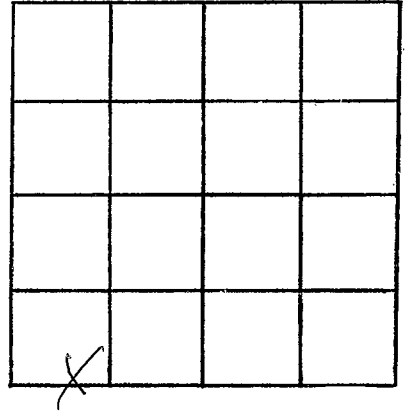

SECTION 28

Please indicate well location X.

ADDITIONAL INFORMATION

If more than one screen,
show locations of each on sketch.