

L? J

RANKIN
OX 81

WATER WELL DRILLERS LOG

Date: Jan 11, 1962, Driller: W. G. Butler County: Rankin

(Name)

CODED

(1) Owner of Land: T. J. Kennedy
(Name)

Brandon, Miss
(Address) 22 35

(2) Location: 1/4, 1/4, Sec. 14 15 16
_____ miles _____, of _____
(distance) (direction) (Nearest Town)

(3) Topography: (Hilly) (Flat) (Level)

(4) Purpose of Well: Domestic
(Domestic Irrigation
Municipal, Industrial, Other)

Description & Color of Materials Sand, Clay, Red Clay, Shell, etc.	Thick- ness Feet	Depth Feet
Top Soil	1-2	
Clay	2-15	
Benite	15-26	
Chalk & sand	28-50	
More sand	50-60	
Sand & chalk	60-70	
sand	70-100	

Information upon completion of well:

(1) Diameter 2 inches.

(2) Total Depth 100 feet.

(3) Water Level 60 feet below top of ground.

(4) Cased to 84, Size 2".

(5) Screen: Size 2", Length 10'.


(6) Were any formations sealed against pollution?
_____ yes, _____ no.

If YES depth of formation _____

Why _____

Drillers Remarks: _____

CODED

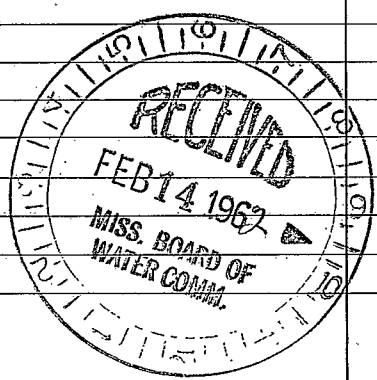

(Use Back Side)

Well No.

