

CODED

X 91
10-3-63

WATER WELL DRILLERS LOG

Date: Oct. 3, 1963, Driller: W. R. Butters County Smith
(Name)

(1) Owner of Land: Reginald Allen
(Name)
Brandon, Rtl. Miss.
(Address)

(2) Location: _____ 1/4, _____ 1/4, Sec. 16 T31R5E
1 miles N, of Puckett
(distance) (direction) (Nearest Town)

(3) Topography: _____
(Hilly) (Flat) (Level)

(4) Purpose of Well: Domestic
(Domestic Irrigation
Municipal, Industrial, Other)

| Description & Color of Materials Sand, Clay, Red Clay, Shell, etc. | Thick- ness Feet | Depth Feet |
|-----------------------------------------------------------------------|------------------------|---------------|
| Chalk | 1-5 | |
| Sand | 5-10 | |
| Chalk | 10-22 | |
| Sand | 22-28 | |
| Chalk | 28-35 | |
| Sand + Chalk | 35-40 | |
| Sand | 40-50 | |

Information upon completion of well:

(1) Diameter 2 inches.

(2) Total Depth 50 feet.

(3) Water Level _____ feet below top of ground.

(4) Cased to 42', Size 2"

(5) Screen: Size 2", Length 5'


(6) Were any formations sealed against pollution?
_____ yes, _____ no.

If YES depth of formation _____

Why _____

Drillers Remarks: _____

CODED

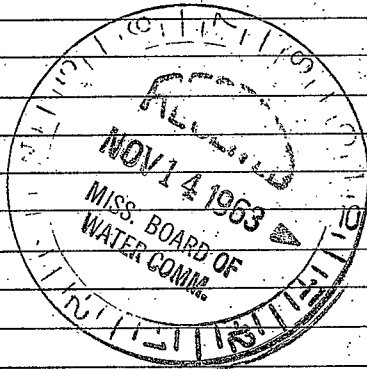

(Use Back Side)

Well No.

