

RANKIN MISSISSIPPI BOARD OF WATER COMMISSIONERS

~~SA~~ X 99

12-23-63

WATER WELL DRILLERS LOG

CODED

CODED

Date: Dec. 23, 1963, Driller: W. G. Butler County Smith
(Name)

- (1) Owner of Land: Ray Cox
(Name)
Brandon, Miss. Rt-
(Address)
- (2) Location: 1/4, 1/4, Sec. 31 T3N R5E
1 miles North, of Johns
(distance) (direction) (Nearest Town)
- (3) Topography: (Hilly) (Flat) (Level)
- (4) Purpose of Well: Domestic
(Domestic Irrigation
Municipal, Industrial, Other)

Description & Color of Materials Sand, Clay, Red Clay, Shell, etc.	Thick- ness Feet	Depth Feet
Red Clay	1-4	
Clay	4-10	
Rock	10-30	
Red Sand	30-76	
Chalk + Sand	76-80	
Sand	80-85	
Chalk + Sand	85-100	
Sand	100-118	
Chalk	118-120	
Sand	120-160	

Information upon completion of well:


- (1) Diameter 2 inches.
- (2) Total Depth 160 feet.
- (3) Water Level 60 feet below top of ground.
- (4) Cased to 147', Size 2"
- (5) Screen: Size 2", Length 11'
- (6) Were any formations sealed against pollution?
_____ yes, _____ no.

If YES depth of formation _____

Why _____

Drillers Remarks: _____

CODED

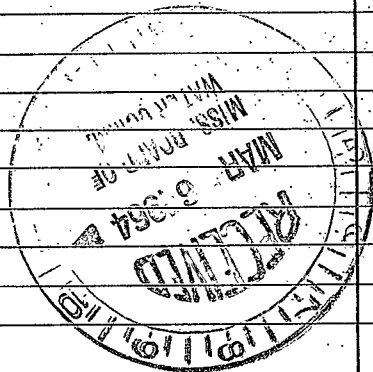

(Use Back Side)

Well No.

1947

Dear Mr. [Name],

I have received your letter of the 15th and am sorry that I cannot give you a more definite answer at this time. The matter is being reviewed and I will be in touch with you again as soon as a final decision has been reached.

Very truly yours,

[Name]

[Address]

[City, State, Zip]