

RANKIN

X106 X107

#77

8/80

Elog #507

MISSISSIPPI BOARD OF WATER COMMISSIONERS 416 North State Street Jackson, Mississippi 39201

CODED

WATER WELL DRILLERS LOG

Quinn Well Saw. Rankin

date well completed

firm name

county well located

LANDOWNER:

Prentiss Calhoun

(mailing address)

WELL LOCATION:

sec. 28 T 3 N R 5 E

miles (distance) of (direction) (nearest town)

WELL PURPOSE:

(home, irrigation, municipal, industrial)

WELL COMPLETION DATA:

- (1) diameter (inches) 4 7/8
(2) total depth (feet) 160
(3) static water level (feet) 140 below top of ground
(4) casing PVC 170 (material) (depth)
(5) screen 10 170 (length) (depth to top)
(6) pump 1 1/2 80 (HP) (yield gpm)
(7) electric log yes
(8) how well bottom plugged Bad

description of formations encountered

from to

Sand & Gravel 0 90
CLAY 90 170
Sand 170 190

CODED

DEPT. OF NATURAL RESOURCES BUREAU OF LAND & WATER RESOURCES


NOV 12 1980

RECEIVED

DRILLERS REMARKS:

If well telescopes please
sketch and show depths.

GROUND LEVEL

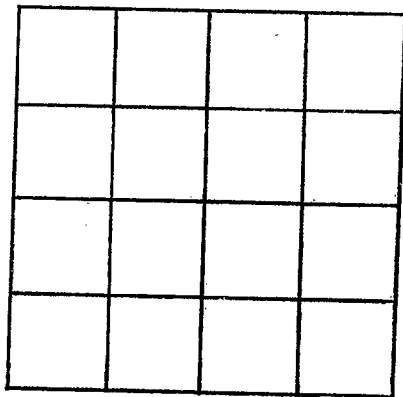

SECTION _____

Please indicate well location X.

ADDITIONAL INFORMATION

If more than one screen,
show locations of each on sketch.