

**KANKIN**  
**X109**  
**8-11-81**

MISSISSIPPI  
 BOARD OF WATER COMMISSIONERS  
 416 North State Street  
 Jackson, Mississippi 39201

**CODED**

**WATER WELL DRILLERS LOG**

8-11-81 1981 Gunn Wadsworth Pinkin  
 date well completed firm name county well located

LANDOWNER:  
NATIONALAC PALLET

description of formations encountered	from	to
<u>CLAY</u>	<u>5</u>	<u>10</u>
<u>CLAY</u>	<u>10</u>	<u>64</u>
<u>ROCK</u>	<u>64</u>	<u>82</u>
<u>CLAY</u>	<u>86</u>	<u>182</u>
<u>SAND</u>	<u>182</u>	<u>209</u>

(mailing address)

WELL LOCATION:  
 sec 24 T 3 N R 5 E  
 S W

\_\_\_\_\_ miles \_\_\_\_\_ of \_\_\_\_\_  
 (distance) (direction) (nearest town)

WELL PURPOSE:  
 (home, irrigation, municipal, industrial)

WELL COMPLETION DATA:

- (1) diameter (inches) 4"
- (2) total depth (feet) 209
- (3) static water level (feet) 10" below top of ground.
- (4) casing PVC 182  
 (material) (depth)
- 4"  
 (size) if telescope see back.
- (5) screen 20' 182  
 (length) (depth to top)
- 4" PVC  
 (size) (material)
- (6) pump 1 1/2 20  
 (HP) (yield gpm)

(type power)

(7) electric log M  
 (yes or no)  
MAS  
 (organization running log)

(8) how well bottom plugged ISWV

DRILLERS REMARKS:


DEPT. OF NATURAL RESOURCES  
 BUREAU OF LAND & WATER RESOURCES

FEB - 4 1982

**RECEIVED**

If well telescopes please sketch and show depths.

GROUND LEVEL

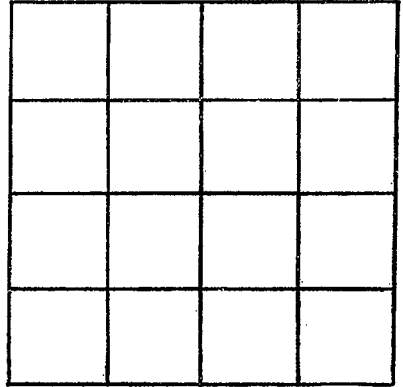

SECTION \_\_\_\_\_

Please indicate well location X.

ADDITIONAL INFORMATION

If more than one screen,  
show locations of each on sketch.