

MISSISSIPPI DEPARTMENT OF NATURAL RESOURCE

Bureau of Land and Water Resources

Southport Mall

P.O. Box 10631

Jackson, Mississippi 39209

WATER WELL DRILLERS LOG

CODED

Rankin
X III
10-20-85

10-20-85 Griner Drilling Service, Inc. Rankin
 date well completed firm name county well located

LANDOWNER:	description of formations encountered	from	to
<u>Ultramar Oil & Gas</u>			
<u>16825 Northchase Dr.</u>	<u>clay</u>	<u>0</u>	<u>120</u>
<u>Suite 1200</u>			
<u>Houston, Texas 77061</u> (mailing address)	<u>SAND</u>	<u>120</u>	<u>150</u>
WELL LOCATION: <u>1820'S + 1828'E</u>	<u>CODED</u>		
sec. <u>31</u> T. <u>30</u> N. R. <u>5</u> E of	<u>clay</u>	<u>150</u>	<u>220</u>
<u>No. 1 Bob H. Benton</u> (distance) <u>1/2</u> miles <u>Puckett</u> (direction) (nearest town)	<u>SAND</u>	<u>220</u>	<u>280</u>
WELL PURPOSE: <u>oilfield supply</u> (home, irrigation, municipal, industrial) <input checked="" type="checkbox"/>	<u>clay</u>	<u>280</u>	<u>357</u>

WELL COMPLETION DATA:

(1) diameter (inches) 3"

(2) total depth (feet) 357'

(3) static water level (feet) 60' below above top of ground.

(4) casing steel, 273' (material) (depth)
3" (size) if telescope see back.

(5) screen 42', 231' (length) (depth to top)
3" (size) perforated (material)

(6) pump — 80-85 (HP) (yield gpm)
AC (type power)

(7) electric log — (yes or no)
 (organization running log) —

(8) how well bottom plugged ORANGE
peel


DRILLERS REMARKS: —

RECEIVED
 NOV - 1 1985

Department of Natural Resources
 Bureau of Land & Water Resources

If well telescopes please
sketch and show depths.

GROUND LEVEL

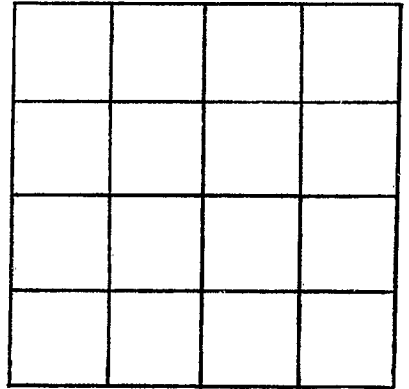

SECTION _____

Please indicate well location X.

ADDITIONAL INFORMATION

If more than one screen,
show locations of each on sketch.