

MISSISSIPPI DEPARTMENT OF ENVIRONMENTAL QUALITY

Office of Land and Water Resources

P. O. Box 10631
Jackson, MS 39289-0631
WATER WELL DRILLERS LOG

COUNTY WELL LOCATED	
Rankin	
WELL NUMBER	CODED
Hutson	X114
8-13	
DATE WELL COMPLETED	
4-06-96	

CODED

PERMIT NUMBER
453
NAME OF DRILLING FIRM
Morphis Brothers
Trout, La. 71371

NAME & MAILING ADDRESS OF LANDOWNER		
Robertson Onshore		
800 East River Place Ste 206		
Jackson, Miss 39202		
WELL LOCATION:	SEC	TOWNSHIP RANGE
	13	3 S 5 E W
DISTANCE	DIRECTION	NEAREST TOWN
1 Miles	N	of Puckett
OTHER LANDMARK		
WELL PURPOSE: Home, Irrigation, Municipal, Industrial, Fish Pond, etc.		
Rig Supply		

PUMP DATA		
PUMP TYPE (Circle One):		
<input checked="" type="radio"/> Submersible Turbine Jet Flowing Well		
Other (Describe) _____		
POWER TYPE (Circle One):		
<input checked="" type="radio"/> Electric Tractor Diesel Gasoline Butane		
Other (Describe) _____ H/P _____		
Pump Capacity (GPM)	No. of Stages	Setting Depth
100		FT.
PUMP TEST		
Well yielded _____ 100 _____ GPM with		
a drawdown of _____ NA _____ ft.		
after _____ NA _____ hours of pumping		

WELL DATA		
Well Depth	Casing Diameter (In.)	Casing Length (Ft.)
60	4	40
Type of Casing	Hole Depth	Depth to Static Water Level
PVC	60	10
TYPE OF COMPLETION: (Circle One or More):		
<input checked="" type="radio"/> Gravel Packed Underreamed Telescoped		
Natural Development, Open Hole, Other		
(Describe) _____		

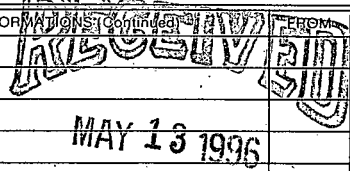
LOG DATA	
TYPE OF LOG RUN (Circle One):	
<input checked="" type="radio"/> No Log Run	
Electric, Gamma Ray, Density, Sonic, Neutron, Other (Describe) _____	
Name of Organization Running Log	

WELL GROUTED TO A DEPTH OF _____ 10 FEET
Type Grout (circle one): <input checked="" type="radio"/> Cement Bentonite, or Mix

GEOLOGIC DATA (Office Use Only)			
Surface Elev.	Geologic Unit	Unit Thickness	Depth to Top
Subs. SWL	Date	Analysis	Aquifer Test

SCREEN DATA		
Diameter - Inches	Length - Feet	Slot Size - Inches
4	20	.020
Screen Type	Depth to Bottom - Feet	
PVC	—	

Driller's Remarks
#1 HUTSON 13-8
2300's & 800' w of
NETCOR

DESCRIPTION OF FORMATIONS ENCOUNTERED	FROM	TO	FORMATIONS (Continued)	FROM	TO
Sandy clay	0	10			
med + coarse yellow sd	10	57			
gray clay	57	80			
Silty gray clay	80	140			
brown clay + sd	140	160			
	160	200			

IF MORE SPACE IS NEEDED, USE BACK

If well telescopes please
sketch and show depths.

GROUND LEVEL

SECTION _____
Please indicate well location X.

ADDITIONAL INFORMATION

If more than one screen,
show location of each on sketch.