

SCOTT MISSISSIPPI BOARD OF WATER COMMISSIONERS

1 A 5
6-15-62

WATER WELL DRILLERS LOG

Date: 6-15, 1962, Driller: Hearon Drilling County Scott
(Name)

(1) Owner of Land: R.D. Slay
(Name)
Rt 3 Lena Miss
(Address)
(2) Location: SE 1/4 NW 1/4, Sec 12 T8R6
4 miles South of Lena
(distance) (direction) (Nearest Town)
(3) Topography: Hilly
(Hilly) (Flat) (Level)
(4) Purpose of Well: Domestic
(Domestic Irrigation
Municipal, Industrial, Other)


Description & Color of Materials Sand, Clay, Red Clay, Shell, etc.	Thick- ness Feet	Depth Feet
<u>Yellow Clay</u>	<u>24</u>	<u>24</u>
<u>Grey silt</u>	<u>48</u>	<u>-</u>
<u>pepper sand</u>	<u>-</u>	<u>71</u>
<u>Grey Clay</u>	<u>19</u>	<u>90</u>
<u>Sand?</u>	<u>1</u>	<u>91</u>
<u>Grey Clay</u>	<u>26</u>	<u>117</u>
<u>Dark Grey Sand</u>		
<u>Clay w/ Pepper</u>		<u>122</u>
<u>Fin Dark Grey</u>	<u>11</u>	<u>-</u>
<u>Sand w/ Pepper</u>	<u>-</u>	<u>-</u>
<u>Shale</u>	<u>-</u>	<u>153</u>
<u>Grey clay</u>	<u>3</u>	<u>157</u>
<u>Fin Dark Grey</u>	<u>61</u>	<u>-</u>
<u>Pepper Sand w/ Clay</u>	<u>217</u>	<u>-</u>

Information upon completion of well:

(1) Diameter 2 inches.
(2) Total Depth 217 feet.
(3) Water Level 30 feet below top of ground.
(4) Cased to 211, Size 2"
(5) Screen: Size 1/4, Length 4
(6) Were any formations sealed against pollution?
no

If YES depth of formation _____
Why _____

Drillers Remarks: _____

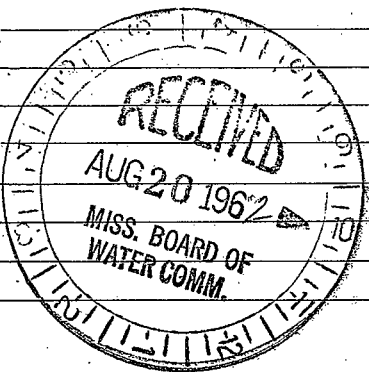

(Use Back Side)

Well No.

