

MISSISSIPPI BOARD OF WATER COMMISSIONERS

WATER WELL DRILLERS LOG

SCOTT
S A 7
3-5-63

Date: 3/5, 1963, Driller: Faust Drilling Co. County: Scott
(Name)

1) Owner of Land: W. O. Coward
(Name)
Forkville, Miss
(Address)

2) Location: 1/4, 1/4, Sec. 28 8 6
T R
4 miles North of Forkville
(distance) (direction) (Nearest Town)

3) Topography: X
(Hilly) (Flat) (Level)

4) Purpose of Well: Home
(Domestic Irrigation
Municipal, Industrial, Other)

Description & Color of Materials Sand, Clay, Red Clay, Shell, etc.	Thick- ness Feet	Depth Feet
Brown Clay	0	22
Blue Clay		55
lime		62
Clay + sandy shell		72
Clay + shell		82
sandy sand		89
Clay + shls mdy sand		122
mdy sand + clay		152
Clay		162
mdy sand + clay		172
hard clay		222
Clay + shls sand		242
Clay		272
Clay + shls sand		287
fine sand		292
fine sand		331

Information upon completion of well:

1) Diameter 2" inches.

2) Total Depth 331 feet.

3) Water Level 90 feet below top of ground.

4) Cased to 321, Size 2"


5) Screen: Size 2", Length 10ft.

6) Were any formations sealed against pollution?
yes, X no.

YES depth of formation _____

Why _____

Drillers Remarks: _____

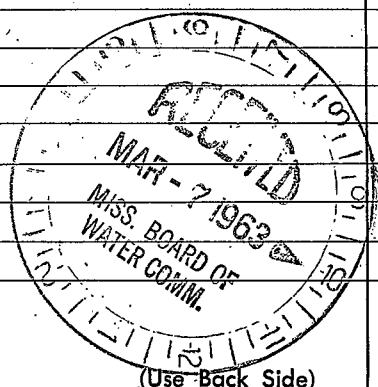

Well No.

