

SCOTT

MISSISSIPPI BOARD OF WATER COMMISSIONERS

5 A 9  
7-26-63

T  
WATER WELL DRILLERS LOG

Date: 7-26, 1963, Driller: Thomas A. Messer Scott County: Scott  
(Name)

(1) Owner of Land: Norm Messer  
(Name)  
Lena R. Miss  
(Address)

(2) Location: 1/4, 1/4, Sec. 12 8 5  
T R  
2 1/2 miles N Ludlow  
(distance) (direction) (Nearest Town)

(3) Topography: ✓  
(Hilly) (Flat) (Level)

(4) Purpose of Well: Domestic  
(Domestic Irrigation  
Municipal, Industrial, Other)

Description & Color of Materials Sand, Clay, Red Clay, Shell, etc.	Thick- ness Feet	Depth Feet
Hard clay	25	25
Extra hard clay	5	30
Soft clay	10	40
Beach dirt	28	68
Rock	2	70
Gray clay	10	80
Gray clay	20	100
Rock	2	102
Shale	26	128
Rock	2	130
Gray clay	20	150
Shale	10	160
hard sand	15	175
Gray clay	5	180
Hard Brown clay	30	210
Dark clay	10	220
Dark sand	70	290
Shale	10	300
Hard shale & rock	40	340
Hard shale	50	390
Sand & shale	70	460
Shale	60	520
Sand Gray	51	571

Information upon completion of well:

(1) Diameter 2 inches.

(2) Total Depth 571 feet.

(3) Water Level 91 feet below top of ground.


(4) Cased to \_\_\_\_\_, Size \_\_\_\_\_

(5) Screen: Size 2 1/2", Length 5'

(6) Were any formations sealed against pollution?  
\_\_\_\_\_ yes, \_\_\_\_\_ no.

If YES depth of formation \_\_\_\_\_  
Why \_\_\_\_\_

Drillers Remarks: air. Cond.  
nessor well

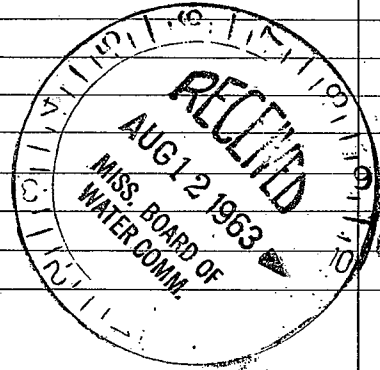

(Use Back Side)

Well No.

RECEIVED  
MAY 19 1964  
U.S. DEPARTMENT OF AGRICULTURE  
WASHINGTON, D.C.