


5 A. 10
7-24-63

6

WATER WELL DRILLERS LOG

Date: 7/24, 1963, Driller: Scott County: Scott

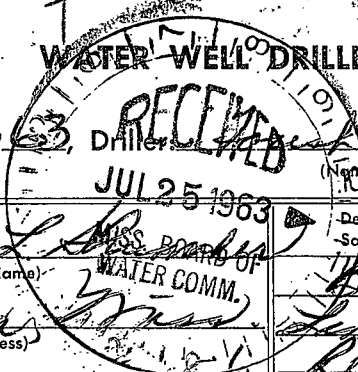

(1) Owner of Land: H. L. ...
(Name)
Rt 3 ...
(Address)

(2) Location: 1/4, 1/4, Sec. 5 T. R
1 miles South of Gulfport
(distance) (direction) (Nearest Town)

(3) Topography: X
(Hilly) (Flat) (Level)

(4) Purpose of Well: Home
(Domestic Irrigation
Municipal, Industrial, Other)

Description & Color of Materials Sand, Clay, Red Clay, Shell, etc.	Thick- ness Feet	Depth Feet
<u>Brown Clay</u>	<u>0</u>	<u>17</u>
<u>Fine sand</u>	<u>29</u>	<u>29</u>
<u>Rock</u>	<u>32</u>	<u>32</u>
<u>Clay & Mgy sand</u>	<u>52</u>	<u>52</u>
<u>Clay</u>	<u>82</u>	<u>82</u>
<u>Clay & Shs sand</u>	<u>182</u>	<u>182</u>
<u>Fine sand</u>	<u>192</u>	<u>192</u>
<u>Clay</u>	<u>232</u>	<u>232</u>
<u>Clay & Shs sand</u>	<u>262</u>	<u>262</u>
<u>Fine sand & Shs clay</u>	<u>277</u>	<u>277</u>
<u>Fine sand</u>	<u>307</u>	<u>307</u>

Information upon completion of well:

(1) Diameter 2" inches.

(2) Total Depth 307 feet.

(3) Water Level 25 feet below top of ground.

(4) Cased to 297, Size 2"

(5) Screen: Size 2", Length 10ft.

(6) Were any formations sealed against pollution?
 _____ yes, Y no.

If YES depth of formation _____

Why _____

Drillers Remarks: _____

(Use Back Side)

Well No.

