

SCOTT MISSISSIPPI BOARD OF WATER COMMISSIONERS

5 A 11 T
12-15-65

WATER WELL DRILLERS LOG

8

Date: 12/15, 1965, Driller: East Drilling County Scott
(Name)

(1) Owner of Land: Wiley Danson
(Name)
Ludlow, Miss
(Address)

(2) Location: 1/4, 1/4, Sec. 2 T 8 R 6
4 miles East of Ludlow
(distance) (direction) (Nearest Town)

(3) Topography: _____
(Hilly) (Flat) (Level)

(4) Purpose of Well: Home
(Domestic Irrigation
Municipal, Industrial, Other)

Description & Color of Materials Sand, Clay, Red Clay, Shell, etc.	Thick- ness Feet	Depth Feet
<u>Brown Clay</u>		<u>22</u>
<u>Clay</u>		<u>82</u>
<u>Clay + fine sand</u>		<u>92</u>
<u>fine sand + Sth. Clay</u>		<u>112</u>
<u>Fine sand</u>		<u>122</u>
<u>fine sand + Sth. Clay</u>		<u>202</u>
<u>Fine sand</u>		<u>241</u>

Information upon completion of well:

(1) Diameter 2 inches.

(2) Total Depth 241 feet.

(3) Water Level 60 feet below top of ground.

(4) Cased to 231, Size 2"


(5) Screen: Size 2", Length 10 ft.

(6) Were any formations sealed against pollution?
_____ yes, no.

If YES depth of formation _____

Why _____

Drillers Remarks: _____

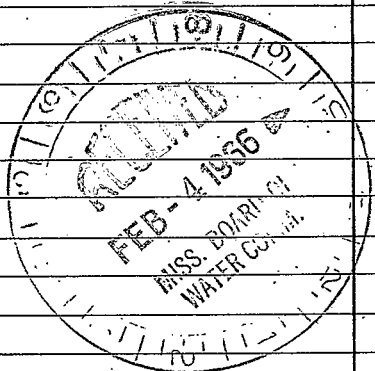

(Use Back Side)

Well No.

