

SCOTT

T

MISSISSIPPI BOARD OF WATER COMMISSIONERS

3-11-66

WATER WELL DRILLERS LOG

9


Date: 3-11, 1966, Driller: LEACH County SCOTT

(1) Owner of Land: Stewart Denson (Name) Ludlow miss (Address) (2) Location: 1/4, 1/4, Sec. 5 8 6 T R (3) Topography: (Hilly) (Flat) (Level) (4) Purpose of Well: (Domestic Irrigation Municipal, Industrial, Other)

Table with 3 columns: Description & Color of Materials, Thickness Feet, Depth Feet. Rows include Clay, Sand, Rock & Sand, Yellow clay, Blue clay, Shell, Sand.

Information upon completion of well:

(1) Diameter 2 inches. (2) Total Depth 309 feet. (3) Water Level 70 feet below top of ground. (4) Cased to 299, Size 7" (5) Screen: Size 2", Length 10 (6) Were any formations sealed against pollution? yes, no.

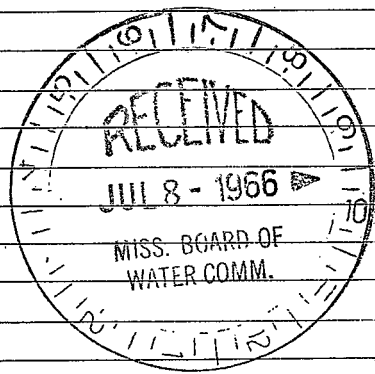

If YES depth of formation Why Drillers Remarks: Yield in gpm: 25 Size pump: 2 hp air Type power:

Total 309

