

SCOTT

5A13

MISSISSIPPI BOARD OF WATER COMMISSIONERS

2-10-66

WATER WELL DRILLERS LOG

Date: 2-10, 1966, Driller: LEACH, County: SCOTT


(1) Owner of Land: M.H. Calhoun (Name), Ludlow MISS (Address), (2) Location: 1/4, 1/4, Sec. 1, 8N SE, 1 miles West of Ludlow, (3) Topography: (Hilly) (Flat) (Level), (4) Purpose of Well: (Domestic Irrigation) (Municipal, Industrial, Other)

Table with 3 columns: Description & Color of Materials, Thickness Feet, Depth Feet. Rows include Clay, Sand, Rock & Sand, Blue clay, Sand with corresponding measurements.

Information upon completion of well:

(1) Diameter: 2 inches, (2) Total Depth: 278 feet, (3) Water Level: 45 feet below top of ground, (4) Cased to: 268, Size: 2", (5) Screen: Size: 2", Length: 10, (6) Were any formations sealed against pollution? yes, no.

If YES depth of formation, Why, Drillers Remarks, Yield in gpm: 20, Size pump: 1 1/2 in., Type power:

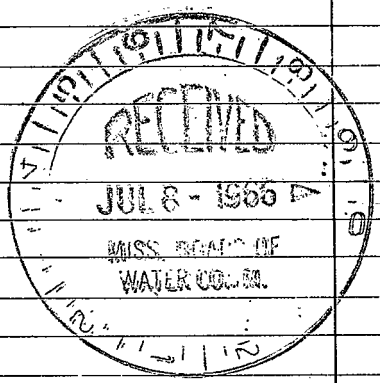

Total 278

