

MISSISSIPPI BOARD OF WATER COMMISSIONERS

Scott  
5 A14  
8-66

T  
WATER WELL DRILLERS LOG

Date: Aug 3, 1966, Driller: Roy Wilkerson County Scott  
(Name)

(1) Owner of Land: Walter Ferrell  
(Name)  
Morton, Miss  
(Address)

(2) Location: 1/4, 1/4, Sec. 17 <sup>B 6</sup> T N R E  
2 miles S, of Ludlow  
(distance) (direction) (Nearest Town)

(3) Topography:  (Hilly)  (Flat)  (Level)

(4) Purpose of Well: Domestic  
(Domestic Irrigation  
Municipal, Industrial, Other)

Description & Color of Materials Sand, Clay, Red Clay, Shell, etc.	Thick- ness Feet	Depth Feet
<u>Sandy</u>	<u>15</u>	
<u>yellow clay</u>	<u>32</u>	
<u>Blue "</u>	<u>20</u>	
<u>Rockery (Layers)</u>	<u>105</u>	
<u>water zone</u>	<u>53</u>	
		<u>237</u>

Information upon completion of well:

(1) Diameter 2 inches.

(2) Total Depth 237 feet.

(3) Water Level 42 feet below top of ground.

(4) Cased to 237, Size 2

(5) Screen: Size 2, Length 6


(6) Were any formations sealed against pollution?  
no

If YES depth of formation \_\_\_\_\_

Why \_\_\_\_\_

Drillers Remarks: \_\_\_\_\_

Pump 6PM 14  
HP 2 (Air compressor)  
Type Power Etc

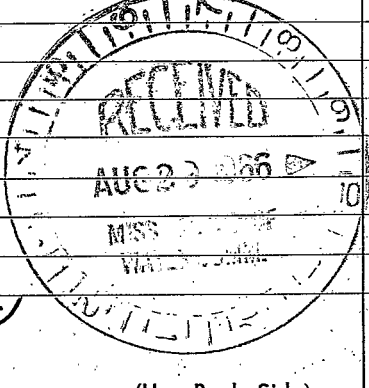

(Use Back Side)

Well No.

