

T
WATER WELL DRILLERS LOG

Scott
S A 15
8-66

Date: Aug 1, 19 66, Driller: Roy Wilkerson County: Scott
(Name)

(1) Owner of Land: Frank Lee
(Name)
Morton, Miss
(Address)
(2) Location: _____ 1/4, _____ 1/4, Sec. 8 8.6 T. N. R. E.
1 miles S of Ludlow
(distance) (direction) (Nearest Town)
(3) Topography: (Hilly) (Flat) (Level)
(4) Purpose of Well: Domestic
(Domestic Irrigation
Municipal, Industrial, Other)

Description & Color of Materials Sand, Clay, Red Clay, Shell, etc.	Thick- ness Feet	Depth Feet
<u>Sandy Top Soil</u>	<u>1.8</u>	
<u>yellow clay</u>	<u>40</u>	
<u>lime rock</u>	<u>4</u>	
<u>Blue shale</u>	<u>120</u>	
<u>Hard rock</u>	<u>12</u>	
<u>water sand</u>	<u>69</u>	
		<u>258</u>


Information upon completion of well:

(1) Diameter 2 inches.
(2) Total Depth 258 feet.
(3) Water Level 22 feet below top of ground.
(4) Cased to 258, Size 2"
(5) Screen: Size 2", Length 6'
(6) Were any formations sealed against pollution?
_____ yes, no.

If YES depth of formation _____

Why _____

Drillers Remarks:
Pump 6PM 18
HP 3 (Air compressor)
Typewriter Elec

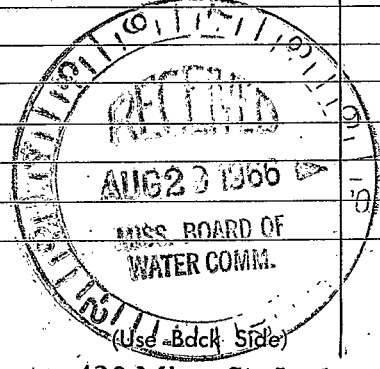

Well No.

