

MISSISSIPPI
BOARD OF WATER COMMISSIONERS
416 North State Street
Jackson, Mississippi 39201

WATER WELL DRILLERS LOG

6-15 1967 Just Dullin Scott
date well completed firm name county well located

LANDOWNER: Odessa Banks
Sudlow,
Miss
(mailing address)

WELL LOCATION:
sec. 4 T. 8N N R. 5E E
S W
2 miles East of Sudlow
(distance) (direction) (nearest town)

WELL PURPOSE:
(home, irrigation, municipal, industrial)

WELL COMPLETION DATA:

- (1) diameter (inches) 2
- (2) total depth (feet) 262
- (3) static water level (feet) 59 below above top of ground.
- (4) casing Galv, 252
(material) (depth)
2" if telescope see back.
(size)
- (5) screen 10 ft, 252
(length) (depth to top)
2" Galv Brass
(size) (material)
- (6) pump _____
(HP) (yield gpm)

(type power)
- (7) electric log no
(yes or no)

(organization running log)
- (8) how well bottom plugged backwash
valve


description of formations encountered	from	to
	<u>Brown clay</u>	<u>0</u>
<u>Blue clay</u>		<u>61</u>
<u>Clay + shs + grey sand</u>		<u>102</u>
<u>Clay sand</u>		<u>181</u>
<u>Fine sand</u>		<u>245</u>
<u>Fair sand</u>		<u>266</u>



DRILLERS REMARKS:

If well telescopes please sketch and show depths.

GROUND LEVEL

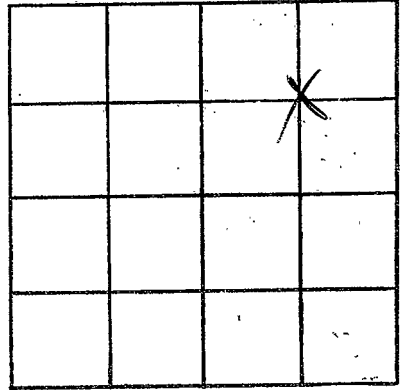

SECTION H

Please indicate well location X.

ADDITIONAL INFORMATION

If more than one screen,
show locations of each on sketch.