

SCOTT MISSISSIPPI BOARD OF WATER COMMISSIONERS

5 A17  
5-3-61

WATER WELL DRILLERS LOG

A

Date: 5-3, 1961, Driller: Hearon Drilling County Scott  
(Name)

(1) Owner of Land: Bruce Rushing  
(Name)  
Marton miss  
(Address)

(2) Location: 1/4, 1/4, Sec. 32 T8 R6,  
1 1/2 miles north, of Martonia  
(distance) (direction) (Nearest Town)

(3) Topography: Flat  
(Hilly) (Flat) (Level)

(4) Purpose of Well: Domestic  
(Domestic Irrigation  
Municipal, Industrial, Other)

Description & Color of Materials Sand, Clay, Red Clay, Shell, etc.	Thick- ness Feet	Depth Feet
White clay	25	25
Blue clay	10	45
Sat + Black Rock	1	46
Blue shale mixture	14	60
hard grey-heavy pebbles	4	64
Lighter of sand	5	69
Brown clay	31	110
Dark grey silty sand	40	150
Mixed clay & rock	17	167
Silty sand grey	33	200
Sand Blue fine	30	230
Grey pebbles sand	25	255
Lighter of clay	2	257
Light grey pebbles sand	28	285

Information upon completion of well:

(1) Diameter 2 inches.

(2) Total Depth 285 feet.


(3) Water Level about 50' Not Measured feet below top of ground.

(4) Cased to 275, Size 2 1/2 inch.

(5) Screen: Size 2 in, Length 10 ft.

(6) Were any formations sealed against pollution?  
no

If YES depth of formation \_\_\_\_\_  
Why \_\_\_\_\_  
Drillers Remarks: \_\_\_\_\_

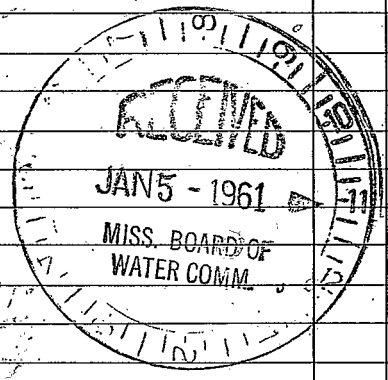

(Use Back Side)

Well No.

