

SCOTT MISSISSIPPI BOARD OF WATER COMMISSIONERS

A 18
4-18-61

WATER WELL DRILLERS LOG

Date: 4-18, 1961, Driller: Marion Drury County: Scott
(Name)

(1) Owner of Land: Joe Davis
(Name)
Rt 7 Lema
(Address)
(2) Location: Unknown SW SE
1/4, 1/4, Sec. T R
5 miles SW of Ludlow
(distance) (direction) (Nearest Town)
(3) Topography: Flat
(Hilly) (Flat) (Level)
(4) Purpose of Well: Domestic
(Domestic Irrigation
Municipal, Industrial, Other) Water


Description & Color of Materials Sand, Clay, Red Clay, Shell, etc.	Thick- ness Feet	Depth Feet
<u>White Clay</u>	<u>25</u>	<u>25</u>
<u>Blue Grey Clay</u>	<u>25</u>	<u>50</u>
<u>Red Clay</u>	<u>33</u>	<u>83</u>
<u>Beck Sand</u>	<u>150</u>	<u>233</u>
<u>Unknown Clay</u>	<u>7</u>	<u>235</u>
<u>Dark Grey Clay</u>	<u>6</u>	<u>241</u>
<u>Brown Clay</u>	<u>4</u>	<u>245</u>
<u>Mix Clay & Sand</u>	<u>16</u>	<u>261</u>
<u>Light Grey Sand</u>	<u>4</u>	<u>265</u>
<u>Water</u>	<u>4</u>	<u>269</u>

Information upon completion of well:

(1) Diameter 4 inches.
(2) Total Depth 612 feet.
(3) Water Level 85 feet below top of ground.
(4) Cased to 602, Size 2"
(5) Screen: Size 2" SS, Length 10'
(6) Were any formations sealed against pollution?
_____ yes, no.

<u>Dark Grey Clay</u>		<u>598</u>
<u>Dark Grey Sand</u>		<u>612</u>

If YES depth of formation _____
Why PH 7.4 No Iron
Drillers Remarks: Part of log
lost Dark Grey Clay
believed to have started
at 269ft.

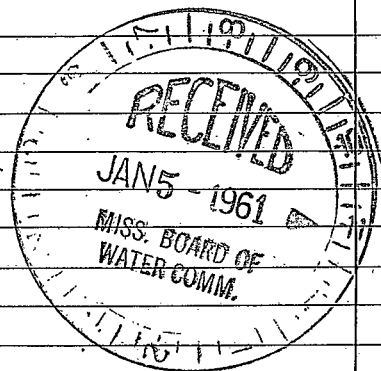

(Use Back Side)

Well No. _____

[The page contains extremely faint and illegible text, likely bleed-through from the reverse side of the document. No specific words or phrases can be discerned.]