

322910N 0874010

4

13T

Scott  
A 20  
10-7-68

MISSISSIPPI  
BOARD OF WATER COMMISSIONERS  
416 North State Street  
Jackson, Mississippi 39201

TECP

WATER WELL DRILLERS LOG

10/7/68 date well completed  
Forest Drilling firm name  
Scott county well located

LANDOWNER: Lee, Bonnie  
Rt. 3  
Senay, Miss.  
(mailing address)

description of formations encountered	CODER	
	from	to
Red Clay	0	20
Red Sand	20	40
Clay	40	81
White Sand & Clay	81	122
Long Sand	122	184
Med Sand	184	286

WELL LOCATION:  
sec 34 T 8 N R 6 E  
miles of (distance) (direction) (nearest town)

WELL PURPOSE: None  
(home, irrigation, municipal, industrial)

WELL COMPLETION DATA:

(1) diameter (inches) 2"

(2) total depth (feet) 283'

(3) static water level (feet) 75' below top of ground.

(4) casing Galv. 283' 273' (material) (depth)

2" if telescope see back. (size)

(5) screen 10' 273' (length) (depth to top)

2" Brass (size) (material)

(6) pump 1 (HP) 4 (yield gpm)

Electric (type power)

(7) electric log NO- (yes or no)

(organization running log)  
(8) how well bottom plugged Rockwell name

DRILLERS REMARKS:


CODER

DEC 30 1966

MISS. Bd. OF WATER COMMISSIONERS

If well telescopes please sketch and show depths.

GROUND LEVEL

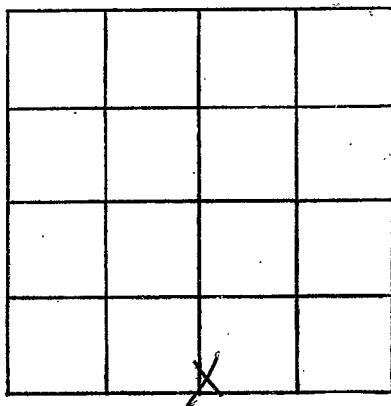

SECTION 34

Please indicate well location X.

ADDITIONAL INFORMATION

If more than one screen, show locations of each on sketch.