

MISSISSIPPI BOARD OF WATER COMMISSIONERS  
416 North State Street  
Jackson, Mississippi 39201

TE CO

WATER WELL DRILLERS LOG

scott  
~~Leade~~  
 A 21  
 10-4-68  
 10/4  
 10/4

date well completed 19 68 firm name Forest Drilling county <sup>Scott</sup> well located Leade

LANDOWNER: W.B. Ellis  
Rt. 3

description of formations encountered	from	to
	Red Clay	0
Red sand	20	30
Clay	30	55
Sand	55	61
streaks sand + clay	61	184
Fine sand	184	286

Sena, Miss  
(mailing address)

WELL LOCATION:  
sec. 2 T. 8 N. R. 6 E  
miles \_\_\_\_\_ of \_\_\_\_\_  
(distance) (direction) (nearest town)

WELL PURPOSE: home  
(home, irrigation, municipal, industrial)

WELL COMPLETION DATA:

(1) diameter (inches) 2"

(2) total depth (feet) 283'

(3) static water level (feet) 69 below above top of ground.

(4) casing Galv, 273'  
(material) (depth)  
2" If telescope see back.  
(size)

(5) screen 10', 273'  
(length) (depth to top)  
2", stainless steel  
(size) (material)

(6) pump 3-, 15  
(HP) (yield gpm)  
Electric  
(type power)

(7) electric log No  
(yes or no)

\_\_\_\_\_  
(organization running log)

(8) how well bottom plugged \_\_\_\_\_

CODED


DEC 30 1968

MISS. DE. OF WATER CONTROL

DRILLERS REMARKS: This well being pumped by 3 HPD low compressor

If well telescopes please sketch and show depths.

GROUND LEVEL

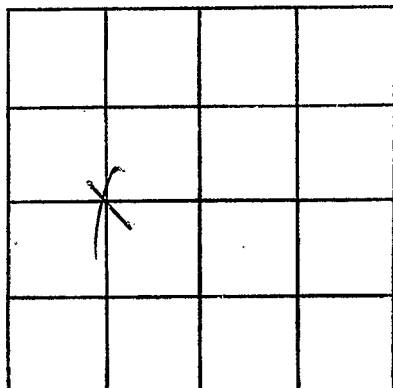

SECTION 7

Please indicate well location X.

ADDITIONAL INFORMATION

If more than one screen, show locations of each on sketch.