

SCOTT
A 22
3-68

MISSISSIPPI
 BOARD OF WATER COMMISSIONERS
 416 North State Street
 Jackson, Mississippi 39201

CODED SCOTT

WATER WELL DRILLERS LOG

3-28 1968 Scott Drilling Co Scott
 date well completed firm name county well located

LANDOWNER Pearl River
water supply assoc.
P.O. Box 12178
Jackson, Miss
 (mailing address)

description of formations encountered	from	to
<u>Red Clay</u>	<u>0</u>	<u>20</u>
<u>red sand</u>	<u>46</u>	<u>81</u>
<u>clay</u>	<u>81</u>	<u>138</u>
<u>clay with sh & sand</u>	<u>138</u>	<u>143</u>
<u>fine sand</u>	<u>143</u>	<u>225</u>
<u>Clay & sh & sand</u>	<u>225</u>	<u>298</u>
<u>shale</u>	<u>298</u>	<u>388</u>
<u>shale & sh & sand</u>	<u>388</u>	<u>440</u>
<u>shale & sh & sand</u>	<u>440</u>	<u>452</u>
<u>fine sand</u>	<u>452</u>	<u>498</u>
<u>shale & sh & sand</u>	<u>498</u>	<u>554</u>
<u>fine sand</u>	<u>554</u>	<u>575</u>
<u>Med Sand</u>	<u>575</u>	

WELL LOCATION:
 sec 13 T 9 N R 5 E
6 miles NW of Lodlow
 (distance) (direction) (nearest town)

WELL PURPOSE:
 (home, irrigation, municipal, industrial)

WELL COMPLETION DATA:

- (1) diameter (inches) 2"
- (2) total depth (feet) 593
- (3) static water level (feet) 159 below above top of ground.
- (4) casing Galv, 583,
 (material) (depth)
2"
 (size) if telescope see back.
- (5) screen 10ft, 583
 (length) (depth to top)
2", Stainless Steel
 (size) (material)
- (6) pump 5HP 1200 GPM
 (HP) (yield gpm)
Electric
 (type power)
- (7) electric log No
 (yes or no)

(organization running log)

(8) how well bottom plugged Backwash
valve

DRILLERS REMARKS: This well
located at the Low
Head Dam on Pearl
River -


CODED

MAY 16 1968

MISS. BD. OF
 WATER CONTROL

If well telescopes please sketch and show depths.

GROUND LEVEL

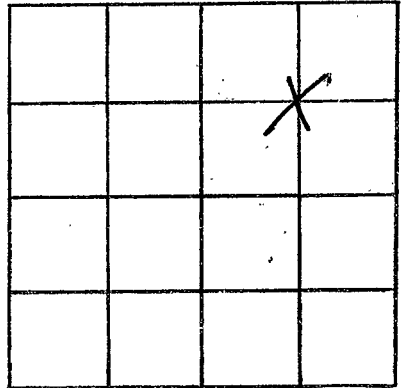

SECTION 13

Please indicate well location X.

ADDITIONAL INFORMATION

If more than one screen, show locations of each on sketch.