

SCOTT  
A25  
6-12-70

MISSISSIPPI  
BOARD OF WATER COMMISSIONERS  
416 North State Street  
Jackson, Mississippi 39201

**CODED**

WATER WELL DRILLERS LOG

6/12 1970 Forest Drilling Scott  
date well completed firm name county well located

LANDOWNER:

description of formations encountered

from

to

Elmwood Minter  
Rt. 3, Minter, Miss.  
(mailing address)

Brown clay	0	26
Blue clay	26	61
Blue clay + shinerock	61	81
Clay + silt	81	102
Sandy clay + rock	102	122
Clay	122	135
Fine sand + clay	135	143
Clay + silt sand	143	204
Shale	204	286
Clay + silt fine sand	286	327
Clay	327	335
Fine sand	335	343
Clay	343	345
Sand	345	363
Clay	363	368

WELL LOCATION:

sec. 36 T. 8 N. R. 45 E.  
8 miles NW of Minter  
(distance) (direction) (nearest town)

WELL PURPOSE: none  
(home, irrigation, municipal, industrial)

WELL COMPLETION DATA:

- (1) diameter (inches) 2"
- (2) total depth (feet) 363'
- (3) static water level (feet) 86' below top of ground.
- (4) casing Steel 348'  
(material) (depth)  
2" if telescope see back.  
(size)
- (5) screen 15' 348'  
(length) (depth to top)  
2" Stainless Steel  
(size) (material)
- (6) pump 3 HP 20  
(HP) (yield gpm)  
Electric  
(type power)
- (7) electric log no  
(yes or no)
- (organization running log)
- (8) how well bottom plugged 2"  
Backwash Valve

**CODED**


AUG 6 1970

DRILLERS REMARKS:

MISSISSIPPI  
BOARD OF WATER COMMISSIONERS  
416 NORTH STATE STREET  
JACKSON, MISSISSIPPI 39201

If well telescopes please  
sketch and show depths.

GROUND LEVEL

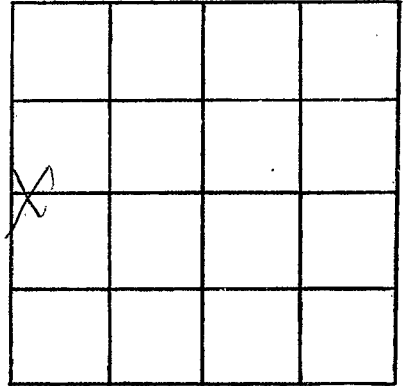

SECTION 36

Please indicate well location X.

ADDITIONAL INFORMATION

If more than one screen,  
show locations of each on sketch.