

SCOTT
A 26
12-14-70

MISSISSIPPI
BOARD OF WATER COMMISSIONERS
416 North State Street
Jackson, Mississippi 39201

CODED

WATER WELL DRILLERS LOG

12/14 1970 Forest Drilling Scott
date well completed firm name county well located

LANDOWNER: Low Head Game Refuge
Box 8721
Jackson, Miss.
(mailing address)

description of formations encountered	from	to
Brown clay + other rock	0	20
clay	20	40
Clay + silt sand	40	61
Fine sand	61	78
Clay	78	81
Fine sand	81	92
clay	92	101
sand	101	119
clay	119	133
Clay + other fine sand	133	140
clay	140	147
Fine sand	147	161
Clay	161	163
Fine sand	163	183
Fine sand	183	204
Clay + other fine sand	204	224
clay	224	240

WELL LOCATION:
sec 25 T. 49 N R. 5 E
4 miles N of Ludlow
(distance) (direction) (nearest town)

WELL PURPOSE:
(home, irrigation, municipal, industrial)

- WELL COMPLETION DATA:
- (1) diameter (inches) 2"
 - (2) total depth (feet) 210'
 - (3) static water level (feet) 23' below above top of ground.
 - (4) casing Steel, 200'
(material) (depth)
 - 2"
(size) If telescope see back.
 - (5) screen 10' 200'
(length) (depth to top)
 - 2", Stainless Steel # 80
(size) (material)
 - (6) pump 3/4 15
(HP) (yield gpm)
 - Fluor
(type power)
 - (7) electric log no
(yes or no)
 - (organization running log)
 - (8) how well bottom plugged 2"
Backwash Valve

CODED

DEC 17 1970


MISS. DEPT. OF
WATER RESOURCES

FOREST DRILLING SERVICE
221 Highway 35 North
Forest, Mississippi

DRILLERS REMARKS:

If well telescopes please sketch and show depths.

GROUND LEVEL

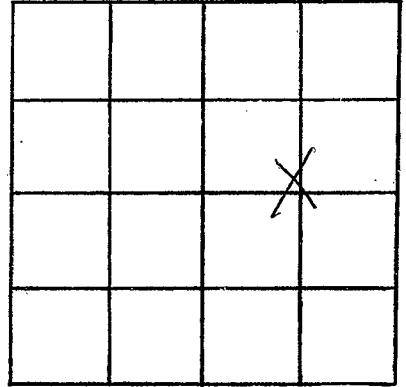

SECTION 25

Please indicate well location X.

ADDITIONAL INFORMATION

If more than one screen,
show locations of each on sketch.