

SCOTT
A27
11-30-70

MISSISSIPPI
BOARD OF WATER COMMISSIONERS
416 North State Street
Jackson, Mississippi 39201

CODED

WATER WELL DRILLERS LOG

11-30-1970 date well completed Forest Drilling firm name Scott county well located

LANDOWNER: J. D. McFarland
Ludlow, Miss.

description of formations encountered	from	to
	Silt + sand	0
Fine sand	38	140
stks. clay, fine sand	140	240
med. sand & lignite	240	290
shale	290	380
shale + stks. rock	380	400
shale	400	530
fine sand	530	590
shale	590	592
fine to med. sand	592	705
stks. lignite + sand	705	724
fine sand	724	745
Soft clay	745	766

(mailing address)

WELL LOCATION:

sec. 7 T. 8 N R. 6 E
2 miles South of Ludlow
(distance) (direction) (nearest town)

WELL PURPOSE: Home
(home, irrigation, municipal, industrial)

WELL COMPLETION DATA:

- (1) diameter (inches) 4 x 2
- (2) total depth (feet) 706
- (3) static water level (feet) 706 below top of ground.
- (4) casing Steel 691'
(material) (depth)
361' - 41'
330' - 21' if telescope see back.
(size)
- (5) screen 15' 691'
(length) (depth to top)
2" S. Steel
(size) (material)
- (6) pump 2 HP 20
(HP) (yield gpm)
220 V
(type power)
- (7) electric log no
(yes or no)

CODED

(organization running log)
(8) how well bottom plugged 21'
backwash valve


FEB 1 1971

DRILLERS REMARKS:

MISS. BD. OF
WATER COMMISSIONERS

If well telescopes please
sketch and show depths.

GROUND LEVEL

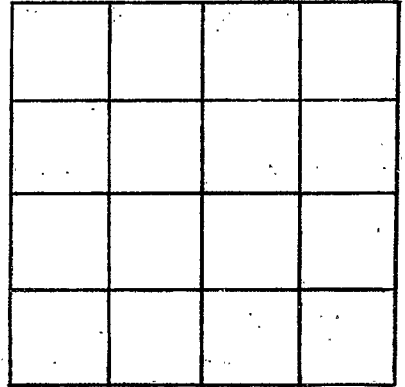

SECTION _____

Please indicate well location X.

ADDITIONAL INFORMATION

If more than one screen,
show locations of each on sketch.