

MISSISSIPPI
BOARD OF WATER COMMISSIONERS
416 North State Street
Jackson, Mississippi 39201

CODED

WATER WELL DRILLERS LOG

SCOTT
A28
2-11-71

2-11 1971 Thomas & Son Scott
date well completed firm name county well located

LANDOWNER: J. K. Burch
Forkville, Miss.
(mailing address)

WELL LOCATION:
sec. 29 T. 8 N. R. 6 E. S. 5 W.
4 miles S of Ludlow
(distance) (direction) (nearest town)

WELL PURPOSE:
home, irrigation, municipal, industrial

WELL COMPLETION DATA:
(1) diameter (inches) 2
(2) total depth (feet) 210
(3) static water level (feet) 35 below top of ground.
(4) casing GALV. 204
(material) (depth)
2" if telescope see back.
(size)
(5) screen 6 104
(length) (depth to top)
2" 636 5-5
(size) (material)
(6) pump 1 Air Compressor 150 G.P.M.
(HP) (yield gpm)
Elec
(type power)
(7) electric log No
(yes or no)
(organization running log)

description of fomations encountered	from	to
<u>Pigeon CLAY</u>	<u>0</u>	<u>15</u>
<u>Red CHALK</u>	<u>15</u>	<u>20</u>
<u>Dirty yellow SAND</u>	<u>20</u>	<u>27</u>
<u>CHALK</u>	<u>27</u>	<u>35</u>
<u>Solid Black DIRT</u>	<u>35</u>	<u>63</u>
<u>Black DIRT & Little STREAKS Fine SAND</u>	<u>63</u>	<u>168</u>
<u>Five SAND</u>	<u>168</u>	<u>200</u>
<u>Course SAND</u>	<u>200</u>	<u>210</u>

CODED


FEB 23 1971

DRILLERS REMARKS:

MISS. Bd. OF
WATER COMM.

If well telescopes please sketch and show depths.

GROUND LEVEL

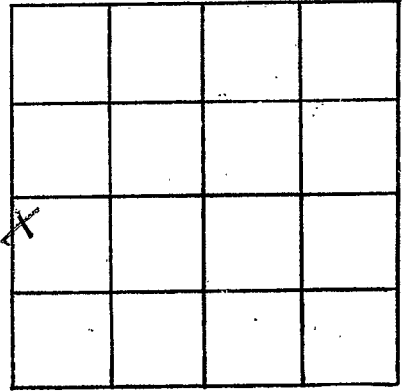

SECTION 29

Please indicate well location X.

ADDITIONAL INFORMATION

If more than one screen,
show locations of each on sketch.