

SCOTT  
A30  
4-3-72

MISSISSIPPI  
BOARD OF WATER COMMISSIONERS  
416 North State Street  
Jackson, Mississippi 39201

**CODED**

WATER WELL DRILLERS LOG

4-3 1972 Comand Drilling Service Scott  
date well completed firm name county well located

LANDOWNER: Clasie  
McAllister  
Lena P#3 Area  
(mailing address)

description of formations encountered	from	to
Clay	0	108
Sand & Clay	108	147
Sand & Clay	147	184
Sand	184	215

WELL LOCATION:  
sec. 14 T. 8 N. R. 5 E  
4 miles SW of Willow  
(distance) (direction) (nearest town)

WELL PURPOSE: Home  
(home, irrigation, municipal, industrial)

WELL COMPLETION DATA:

(1) diameter (inches) 2"

(2) total depth (feet) 215

(3) static water level (feet) 75 below above top of ground.

(4) casing Steel 210  
(material) (depth)  
(size) if telescope see back.

(5) screen 5 210  
(length) (depth to top)  
1/4 5/8  
(size) (material)

(6) pump 1 4  
(HP) (yield gpm)  
Electric  
(type power)

(7) electric log No  
(yes or no)  
(organization running log)

**CODED**


(8) how well bottom plugged \_\_\_\_\_

DRILLERS REMARKS: \_\_\_\_\_

APR 14 1972  
MISS. BD. OF  
WATER COMM.

If well telescopes please sketch and show depths.

GROUND LEVEL

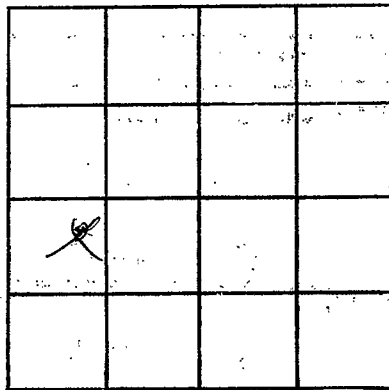

SECTION 14

Please indicate well location X.

ADDITIONAL INFORMATION

If more than one screen, show locations of each on sketch.