

SCOTT
A 2000
5-25-77

MISSISSIPPI
BOARD OF WATER COMMISSIONERS
416 North State Street
13T Jackson, Mississippi 39201

WATER WELL DRILLERS LOG

5-25 1977 date well completed
Thomas & Son firm name
Scott county well located

LANDOWNER: Coy Shomaker
Ludlow Miss
(mailing address)
WELL LOCATION:
sec. 3 T 3 N R 5 E
3 1/2 miles W of Ludlow
(distance) (direction) (nearest town)

WELL PURPOSE:
(home, irrigation, municipal, industrial)

- WELL COMPLETION DATA:
- (1) diameter (inches) 2
 - (2) total depth (feet) 540
 - (3) static water level (feet) 60 below top of ground
 - (4) casing (material) PVC (depth) 525
2 (size) if telescope see back.
 - (5) screen (length) 15 (depth to top) 525
2" (size) 8 slot stainless (material)
 - (6) pump (HP) 3 Air (yield gpm) 20
Elec. (type power)
 - (7) electric log No (yes or no)
 - (organization running log)
 - (8) how well bottom plugged 100%

description of formations encountered	from	to
CHALK	0	25
Little Rock & Grey Chalk	25	45
BLACK DIRT	45	84
Fire DIRT SAND	84	108
BLACK DIRT MISTY SAND	108	180
BLACK DIRT	180	205
CHALK & FIRE SAND	205	260
COURSE SAND	260	273
CHALK & SILTY SAND	273	320
Grey Chalk	320	373
Little Rock 2"	373	
Grey Chalk	373	428
Little Rock 3"	428	
BLACK & Grey CHALK	428	510
SAND	510	540


RECEIVED

JUN 9 1977

DRILLERS REMARKS:

If well telescopes please sketch and show depths.

GROUND LEVEL

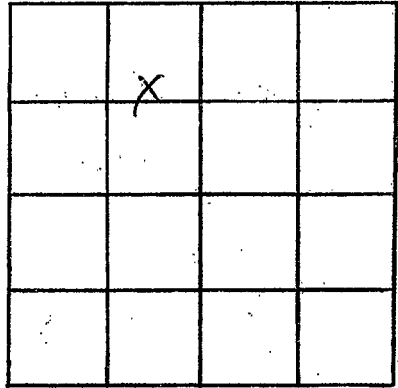

SECTION 3

Please indicate well location X:

ADDITIONAL INFORMATION

If more than one screen,
show locations of each on sketch.