

SCOTT
A 2001
6/1/77

MISSISSIPPI
BOARD OF WATER COMMISSIONERS
416 North State Street
Jackson, Mississippi 39201

WATER WELL DRILLERS LOG

June 19 77 ^{13T} Thomson Scott
date well completed firm name county well located

LANDOWNER: <u>Pleasant Grove Church</u> <u>Ludlow, Miss.</u> (mailing address)	description of formations encountered	from	to
		0	18
WELL LOCATION: sec. <u>14</u> T. <u>4</u> (N) R. <u>5</u> (E) <u>2 1/2</u> miles <u>SW</u> of <u>Ludlow</u> (distance) (direction) (nearest town)	<u>CHALK</u>	<u>18</u>	<u>30</u>
	<u>CLAY</u>	<u>30</u>	<u>60</u>
	<u>Blue CHALK</u>	<u>60</u>	<u>67</u>
	<u>Soft CHALK & Little Rock</u>	<u>67</u>	<u>68</u>
	<u>RECK</u>	<u>68</u>	<u>103</u>
	<u>BLACK DIRT</u>	<u>103</u>	<u>147</u>
	<u>Mostly CHALK Little</u>	<u>147</u>	<u>210</u>
	<u>5th SAND</u>	<u>210</u>	<u>226</u>
	<u>Mostly SAND w/ CHALK</u>		
	<u>SAND</u>		
WELL PURPOSE: <u>Church</u> (home, irrigation, municipal, industrial)			

- WELL COMPLETION DATA:
- (1) diameter (inches) 2
 - (2) total depth (feet) 226
 - (3) static water level (feet) 90 ^{below} _{above} top of ground
 - (4) casing Pvc, 216
(material) (depth)
2 (size) if telescope see back.
 - (5) screen 10 216
(length) (depth to top)
2" 8 slot Pvc.
(size) (material)
 - (6) pump 2 Air 12
(HP) (yield gpm)
ELC.
(type power)
 - (7) electric log No
(yes or no)
- (organization running log)


(8) how well bottom plugged part

DRILLERS REMARKS:

RECEIVED
AUG 11 1977
MISS. Bd. OF WATER COMM.

If well telescopes please sketch and show depths.

GROUND LEVEL

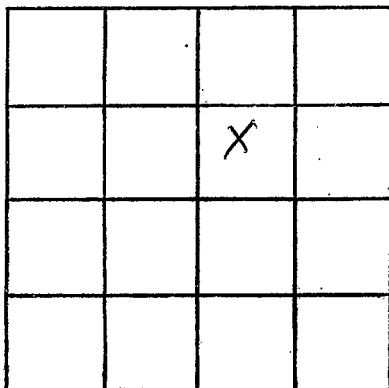

SECTION 14

Please indicate well location X.

ADDITIONAL INFORMATION

If more than one screen,
show locations of each on sketch.