

Scott  
A  
2002

MISSISSIPPI  
BOARD OF WATER COMMISSIONERS  
416 North State Street  
Jackson, Mississippi 39201

WATER WELL DRILLERS LOG

3-30 1982 THOMAS SCOTT  
date well completed firm name county well located

LANDOWNER: Eddie THOMAS  
Rt 2  
Ben A, MS  
(mailing address)

description of formations encountered	from	to
Yellow Pipe Clay	0	30
Blue Clay	30	60
SOFT Grey CHALK	60	70
5 1/2" Fine Dirty Grey Silt	70	
Grey Chalk		80
SOFT Grey CHALK	80	150
SAND FINE	150	245

WELL LOCATION:  
sec. 14 T-8 N R-5 E  
S W  
12 miles NW of Morton  
(distance) (direction) (nearest town)

WELL PURPOSE:  
(home, irrigation, municipal, industrial)

- WELL COMPLETION DATA:
- (1) diameter (inches) 2
  - (2) total depth (feet) 245
  - (3) static water level (feet) 85 below top of ground.
  - (4) casing Pvc, 130,  
(material) (depth)
  - 2 if telescope see back.  
(size)
  - (5) screen 15 ft, 130  
(length) (depth to top)
  - 2", 8 slot Pvc  
(size) (material)
  - (6) pump 2 Air, 15  
(HP) (yield gpm)
  - elec  
(type power)
  - (7) electric log NO  
(yes or no)

(organization running log)  
(8) how well bottom plugged POINT

DRILLERS REMARKS:


DEPT. OF NATURAL RESOURCES  
BUREAU OF LAND & WATER RESOURCES

APR 2 1982

RECEIVED

If well telescopes please sketch and show depths.

GROUND LEVEL

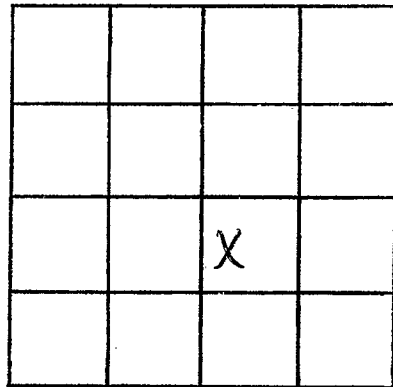

SECTION 14

Please indicate well location X.

ADDITIONAL INFORMATION

A series of horizontal lines for writing additional information.

If more than one screen, show locations of each on sketch.