

MISSISSIPPI DEPARTMENT OF NATURAL RESOURCES

Bureau of Land and Water Resources

Southport Mall

P.O. Box 10631

Jackson, Mississippi 39209

WATER WELL DRILLERS LOG

SCOTT  
A  
2003

5-22 1983 Thomas + son Scott  
date well completed firm name county well located

LANDOWNER: <u>Thomas Miles</u>	description of formations encountered	from	to
LADLOW MISS (mailing address)  WELL LOCATION: sec. <u>14</u> T <u>18</u> N R. <u>5</u> E <u>4</u> miles <u>Southwest</u> of <u>Ladlow</u> (distance) (direction) (nearest town)  WELL PURPOSE: (home, irrigation, municipal, industrial)  WELL COMPLETION DATA: (1) diameter (inches) <u>2"</u> (2) total depth (feet) <u>320'</u> (3) static water level (feet) <u>53</u> below above top of ground. (4) casing <u>PVC</u> <u>290'</u> (material) (depth) <u>2"</u> if telescope see back. (size) (5) screen <u>20'</u> <u>300'</u> (length) (depth to top) <u>2"</u> <u>PVC</u> (size) (material) (6) pump <u>10</u> (HP) (yield gpm) <u>Electric</u> (type power) (7) electric log <u>No</u> (yes or no) (organization running log) (8) how well bottom plugged <u>Open</u>	<u>Red Chalk</u> <u>Gray Chalk</u> <u>DARK GRAY CHALK</u> <u>Fine Gray sand</u> <u>Gray Chalk</u> <u>Fine Gray sand</u> <u>Gray Chalk</u> <u>White sand (fine)</u>	<u>0</u> <u>26</u> <u>68</u> <u>104</u> <u>188</u> <u>255</u> <u>278</u> <u>294</u>	<u>26</u> <u>68</u> <u>104</u> <u>188</u> <u>255</u> <u>278</u> <u>320</u>

DEPT. OF NATURAL RESOURCES  
BUREAU OF LAND & WATER RESOURCES


MAY 23 1983

RECEIVED

DRILLERS REMARKS:

If well telescopes please sketch and show depths.

GROUND LEVEL

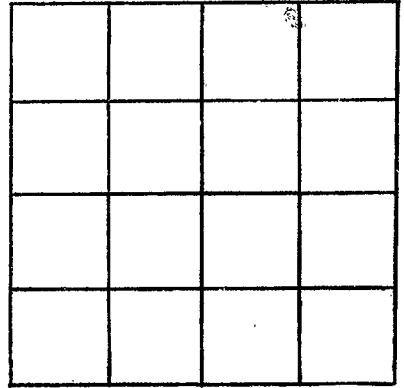

SECTION \_\_\_\_\_

Please indicate well location X.

ADDITIONAL INFORMATION

If more than one screen,  
show locations of each on sketch.