

MISSISSIPPI DEPARTMENT OF NATURAL RESOURCES

Bureau of Land and Water Resources

Southport Mall

P.O. Box 10631

Jackson, Mississippi 39209

WATER WELL DRILLERS LOG

Scott  
A  
2004

SCOTT  
~~SCOTT~~ CO

10/9 1984 Thomas & son date well completed firm name county well located

LANDOWNER: James Bowen  
At  
Leda Miss  
(mailing address)

description of formations encountered	from	to
Gray Chalk	0	36
Blue Chalk	36	52
Black Chalk	52	86
Green Fine Sand	86	137
White Coarse Sand	137	215

WELL LOCATION:  
sec. 14 T. 8 N. R. 5 E  
S W  
4 miles Southside of Ludlow  
(distance) (direction) (nearest town)

Deep 215

WELL PURPOSE:  
(home, irrigation, municipal, industrial)

WELL COMPLETION DATA:

(1) diameter (inches) 2"

(2) total depth (feet) 215'

(3) static water level (feet) 88' below top of ground.

(4) casing PVC 215' (material) (depth)  
2" (size) if telescope see back.

(5) screen 10' 215' (length) (depth to top)  
2" (size) PVC (material)

(6) pump 1/2 HP 10 (yield gpm)  
Eberhart (type power)

(7) electric log no (yes or no)  
(organization running log)

(8) how well bottom plugged screen

DEPT. OF NATURAL RESOURCES  
BUREAU OF LAND & WATER RESOURCES


OCT 26 1984

RECEIVED

DRILLERS REMARKS:

If well telescopes please  
sketch and show depths.

GROUND LEVEL

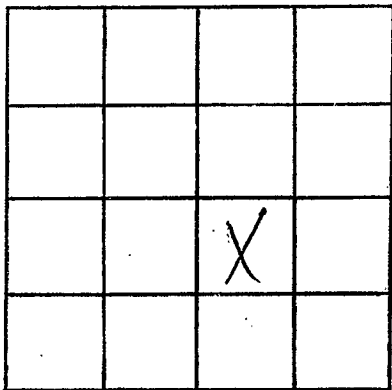

SECTION \_\_\_\_\_

Please indicate well location X.

ADDITIONAL INFORMATION

If more than one screen,  
show locations of each on sketch.